10

Sec. 21 T. 3N R. 36E

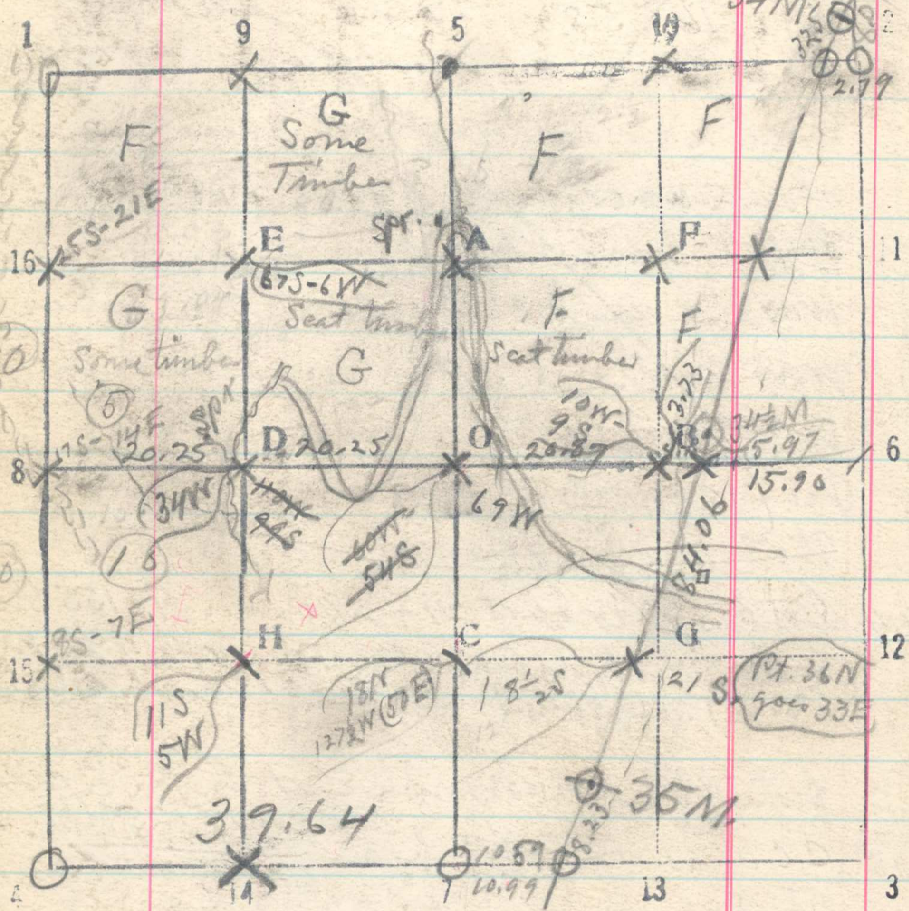

From CC of 21 & 28 run N. 20° E

8.23 35 M cor.

21.20 Set stake for CC. of Lots

30.30 34½ M cor bears 302° to right of line

31.20 Set stake

42.03 Set stake for C.C on E&W center line at N.E.B. Mathew Duffy altmt

48.00 34½ M cor bears S70°E. 98 lks.

Thence N 20° E by B.S. on 35M

63.04 Set stake for CC bet two lots.

84.06 CC of Secs. 16 & 21. bears W. lks. 39.34

(39.34) 34 M. cor bears W. 109 lks. 3.28

3.28 36.06

From stake on E&W center line on Rs. bdry run W.

3.73 Set 1/16 cor B-S. 21

24.10 Set 1/4 cor O-S. 21

44.10 Set 1/16 cor D-S. 21

64.10 Set stake.

1.60

65.70 North bet 20 & 21.

20.00 Set 1/16 cor.

40.00 Set 1/4 cor.

60.00 Set 1/16 cor.

79.66 Cor of 16. 17. 20 & 21 bears E. 28 lks. 11/16/18

64) 160 (2.5
128
320
320

64) 144 (2¼
128
160

69
186
2) 255
127½W

21.20
8.23
12.97
.36
13.33

2½ 40-78
4) 84.06
21.01½
21.20
18½S

48.00
31.20
17.00
4

30.30
8.23
22.07

10.69
3.73
14.42

20-49
7
23-56E

31.20
8.23
23.00

49
5
54