


Sec. 1 T. 1 R. 33

Examiner \_\_\_\_\_ Date 4/11 19\_\_

175  
272  
262 1/2

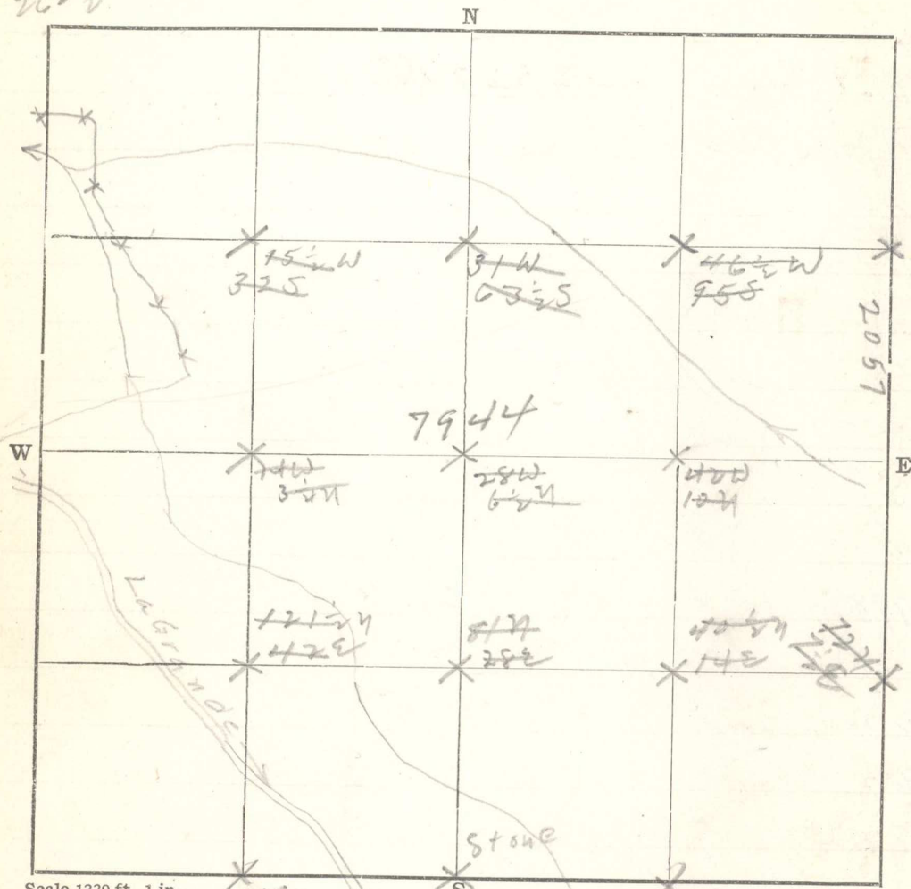

Scale 1320 ft. 1 in.

E from Cor 8 88

20

40

60

80

Do not find 1/2 Cor - Drive stake

4/16  
E from Cor 16

20

40

60

7938 Cor 11 bears S 127 lbs.

S from Cor 6

20

3856

Cor 4 bears E 15 lbs.

W from Cor 12

20

40

60

7944 Cor 13 bears N 162 lbs.

4/17

Perman lines 6-8 = 7944

Set stakes at Cors D, O and B

W from Cor 3

20

40

60

7985 Cor 4 bears 11 lbs S

340