


12

Sec. 4 T. 1N R. 35E

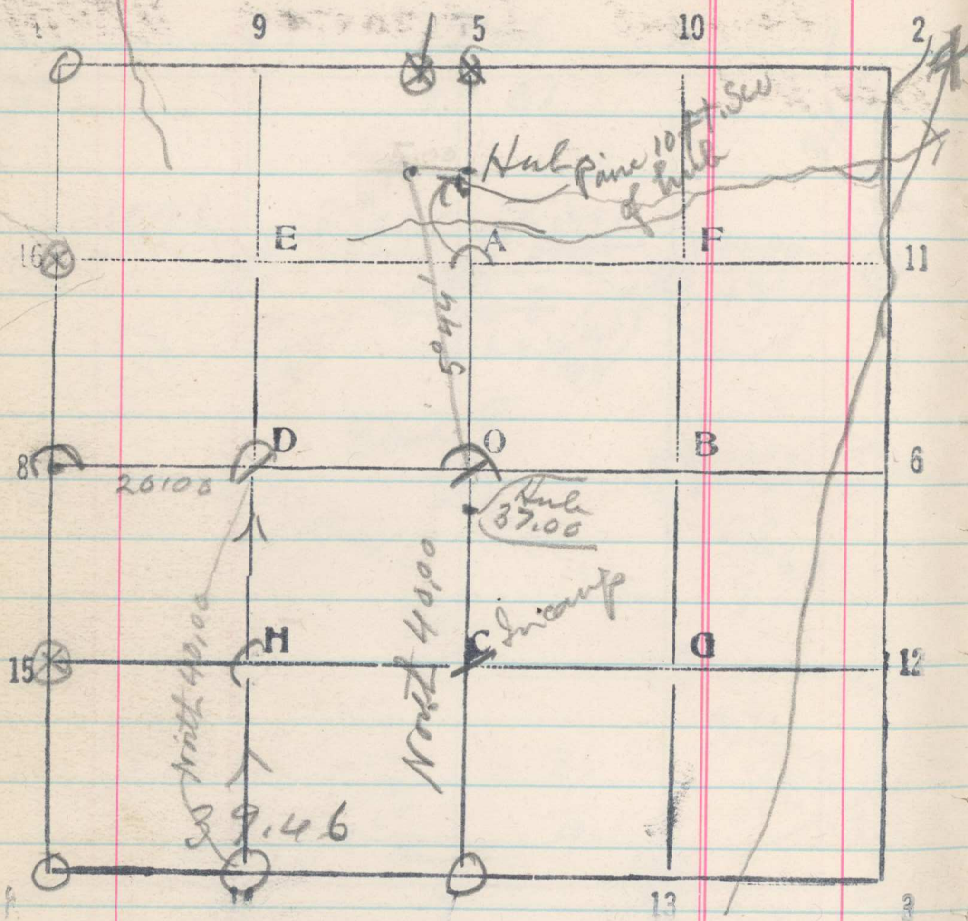

Line 7-5 Set 20 + 40  
37.00 Hub

294  
WPM

North on line 14-D

Set 20 + 40

East on line 8-0

201 Set stake

WPM