24

Sec. 5 T. 2N R. 33E

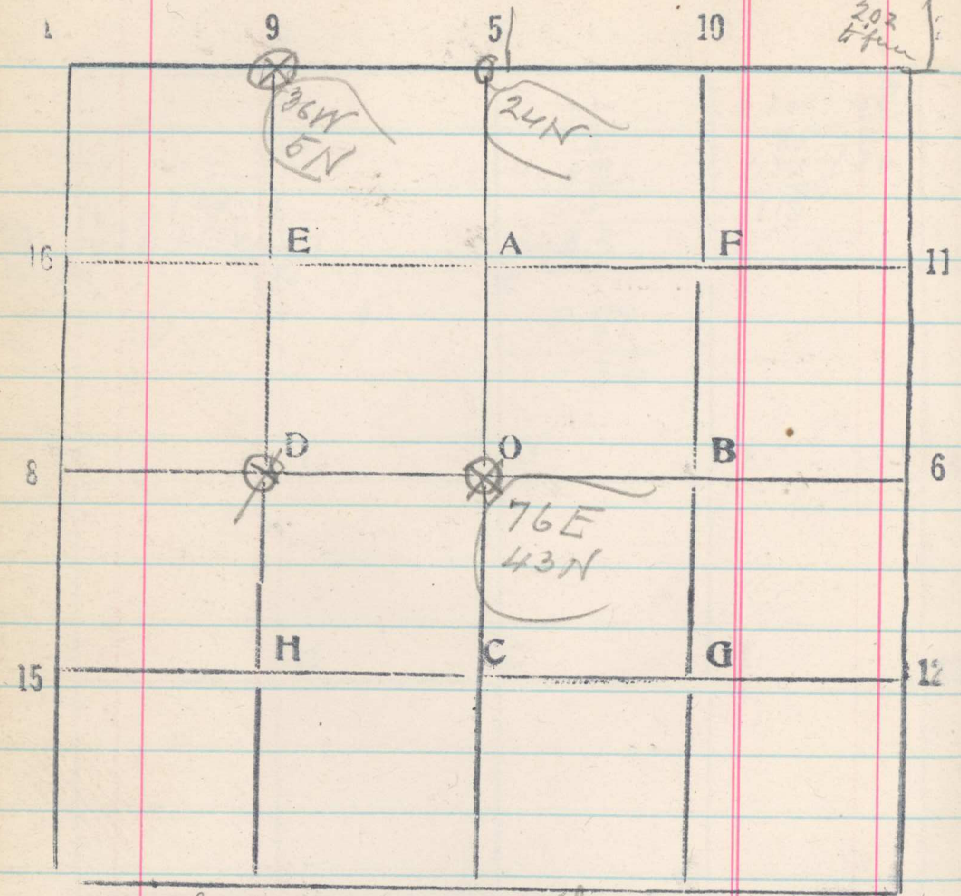

fence to N is 202 lks E. of cor of 4 & 5 from cor of secs 4 & 5 under fence run West.

00 Set 1/16

37.45 Fence cor, N & E, thence in plowed field

40 Set 1/4 cor for sec 5

60 Set 9-5.5

80.48 Cor of secs 5 & 6, an iron post bears N. 11 lks.

Line 8-6

Set 20 & 40

81.52 1/4 cor bet secs 4 & 5 bears N. 86 lks.

Dec. 24. 1919