


Sec. 15 T. 2 R. 33

Examiner _____ Date 4/4 19__

45
20
30
60

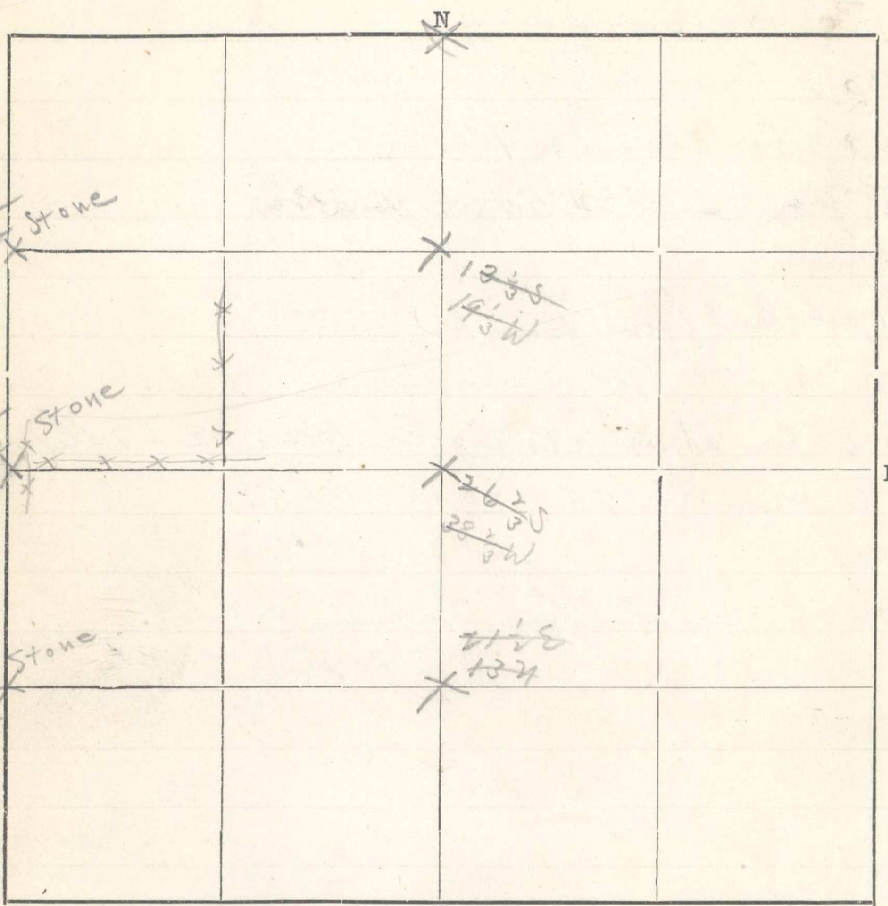

Scale 1320 ft. 1 in.

S from Cr 1-15

20 3975 fence runs E

40

60

8045 Cr 4 bears W 24 lbs.

E from Cr 15-S15

40

337

8043 Cr 12-S15 bears N 26 lbs.

N from Cr C-S15

20

40

6040 Cr 5-S15 bears W 5 lbs.

4/24 -

Re-run lines from Cr ~~A~~ C

6040 - Set posts at Cr. A-O+C.