


29

Sec. 9

T. 2N

R. 34E

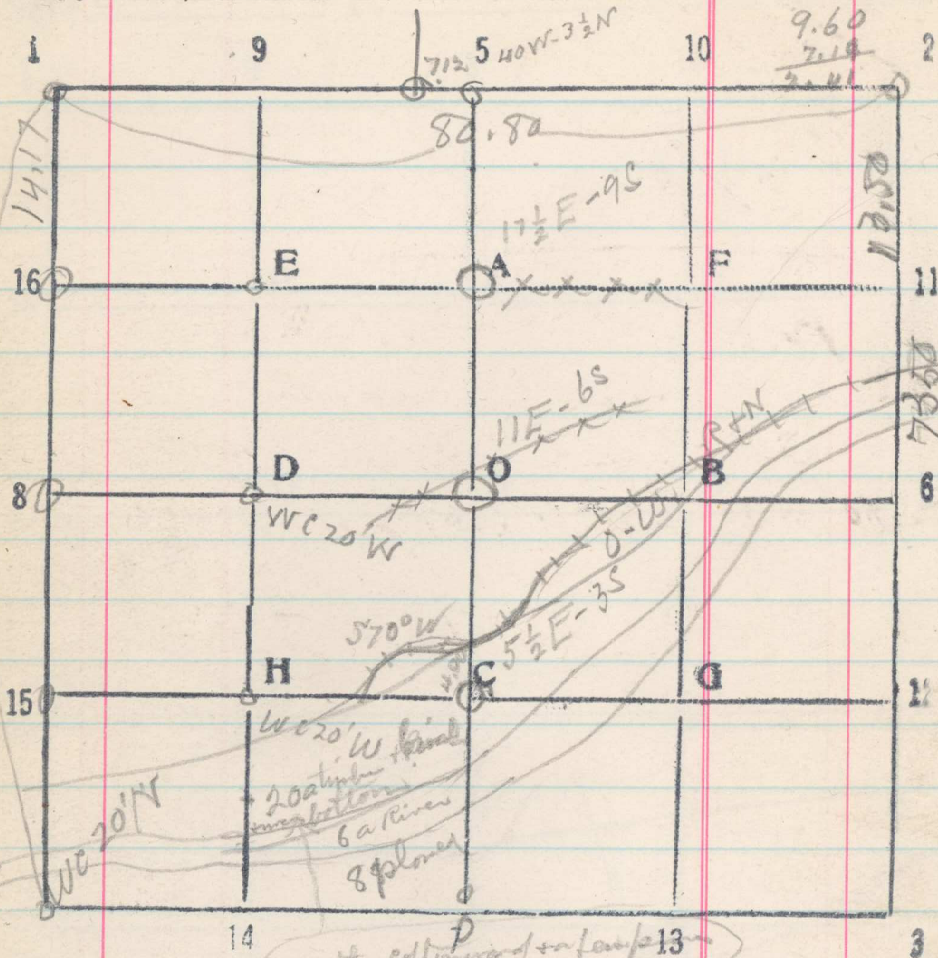

Line 7-5

Set 20.40.6 &

(7350)
7486 1/4 cov bears E. 21 lks

73.50
74.16

3147.66
73.83

73.96
13.

311

From ccofrees, 2 + 3 run West
40.26 Set 1/4 cov for sec 3,
47.45 Set 1/4 cov for sec 34 ^{on line with} _{part of}
80.80 Intersect ccofrees 3 + 4
Jan 8, 1919