


Sec. 718 T. 2 R. 34

Examiner _____ Date 4/27 1915

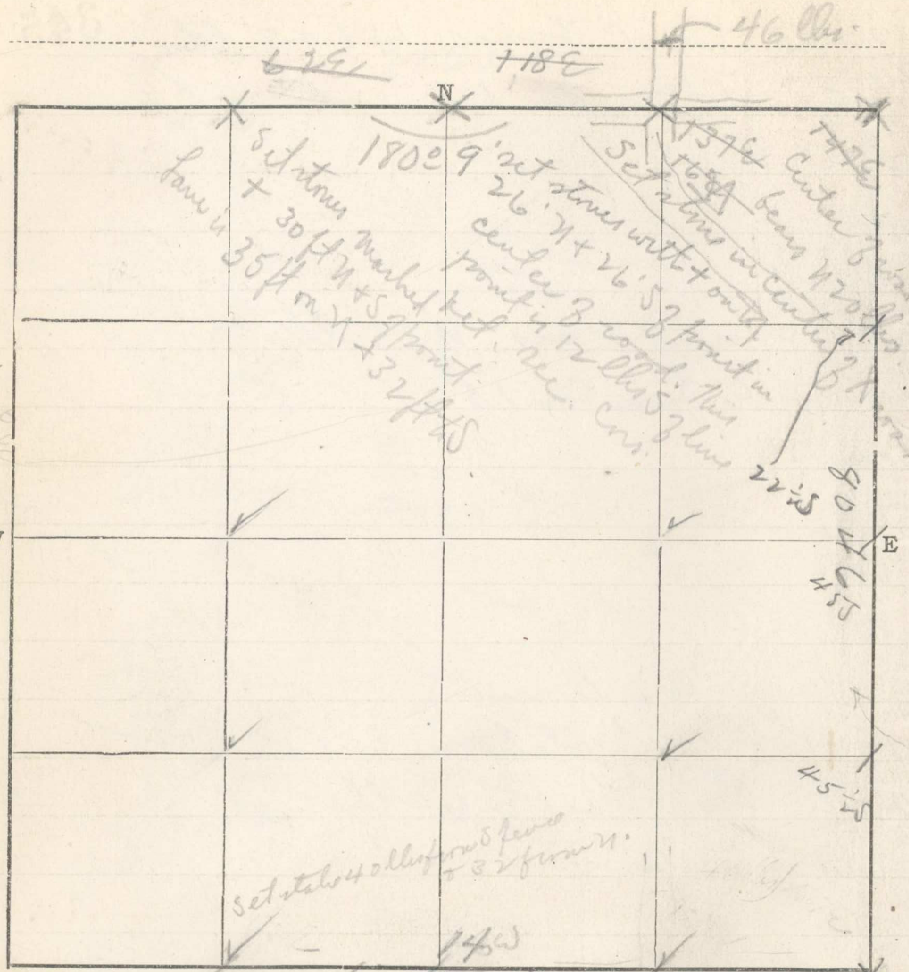

36
12
40

4420
2444
2008

St from cr 2

20

40

60

80 set stakes

5/11 - W from cr 3

20

40

60

8436 Cr 4 bears 8 lbs 5

346

+45 fence E & W

1979 - Center line 445

+21 fence W

E from cr 4

2390

4390

6390

8390

(8490)

2 in center lines

+119

+137

+150

fence S quarter block

fences N & S

Roads N & S

See cr has been plowed out no stones