


2
15 T. 2N R. 35E

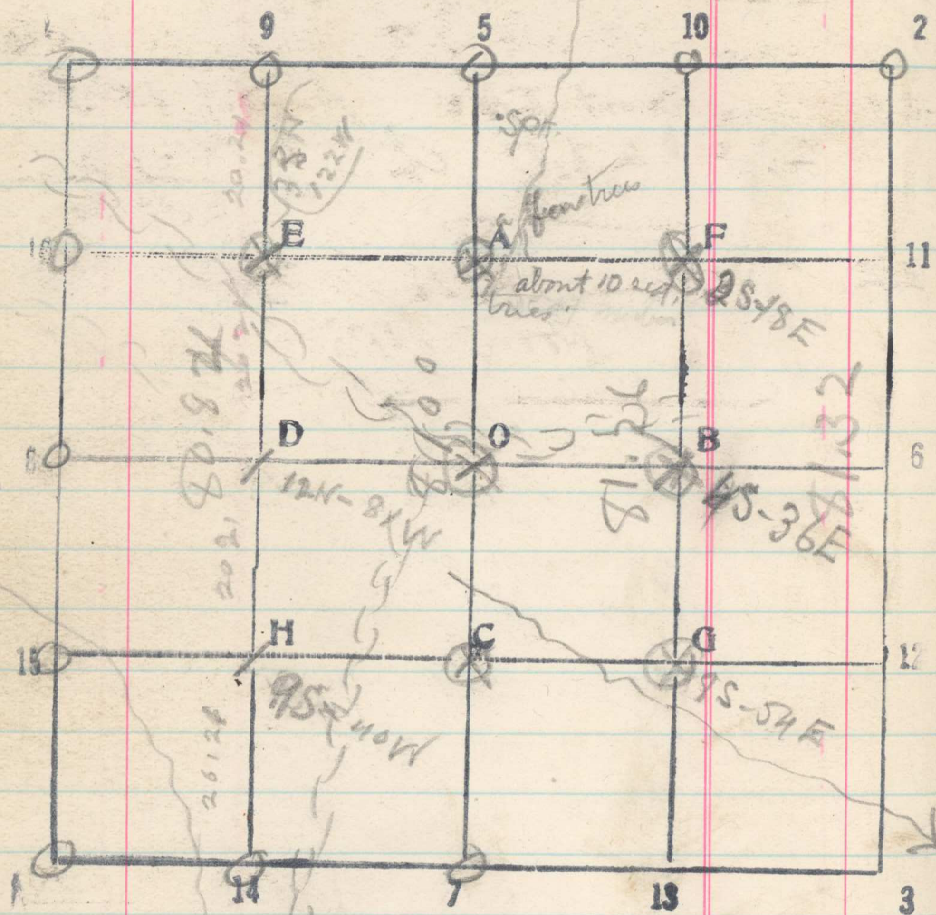

Oct. 30, 1919, Line 14-9
Set 20, 40 x 60
80.84 Cor 9 bears W 160 lbs, Nov 7
Set 30 1919

Nov 5 Line 7-5, Set 20, 40 x 60
81.00 Cor 5 bears W, 160 lbs.

Line 10-13 Set, 20, 30, 40, 60 x 60, 90

55.90 Base West 5.00 Angle, 110° 52'

Dist 23.81 Ch.
1.132
23.80

81.26 Cor 13 bears E 72 lbs,

Nov. 5, 1919,

284
72
36
15

54E