Sec. 17 T. 2 N R. 35 E

Examiner ..... Date ..... 19....

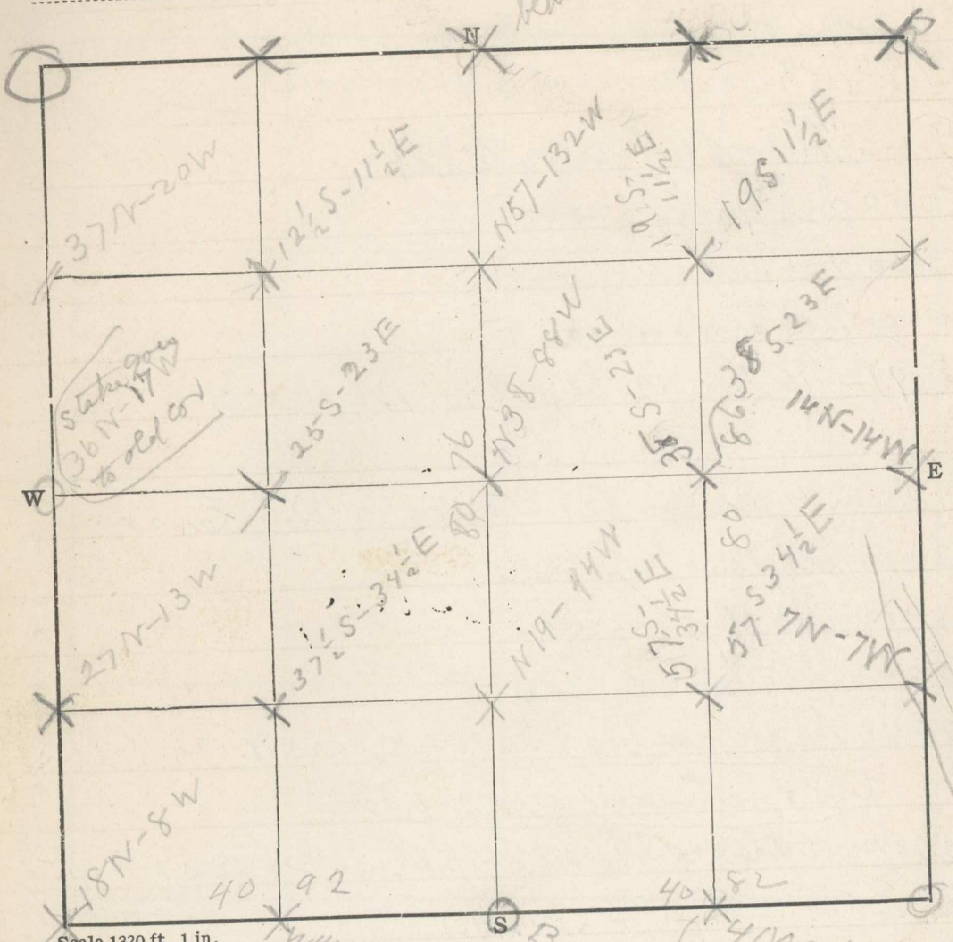

From cor to secs 16, 17, 20 & 21 run W
bet secs 17 & 20
20.00 Set Tem 1/16 cor
40.82 1/4 cor bears North 23 lks

From 1/4 sec cor bet secs 17 & 20 Run North
20.00 Set Tem 1/16 cor A
40.00 Set tem 1/4 cor
60.00 Set tem 1/16 cor C. Aug 26
80.76 1/4 cor bet secs 8 & 17 bears W 76 lks dist

Sec 17

From 1/16 cor 10 Run South
20.00 Set tem 1/16 cor F
40.00 Set tem 1/16 cor B
60.00 Set Tem 1/16 cor G
80.76 1/16 cor 13 bears E. 46 lks.

From 1/4 cor bet secs 17 & 20 run West
20.00 Set tem 1/16 cor 14
40.92 Cor to secs 17, 18, 19 & 20 bears N 43 lks
From 1/16 cor (9) run South
20.00 Set 1/16 cor E on ridge W of low knoll
40.00 Set 1/16 cor D in bunch on N slope of short ravine
60.00 Set tem 1/16 cor
80.50 1/16 cor 14 bears E 46 lks