Sec. 19 T. 2 N. R. 36 E

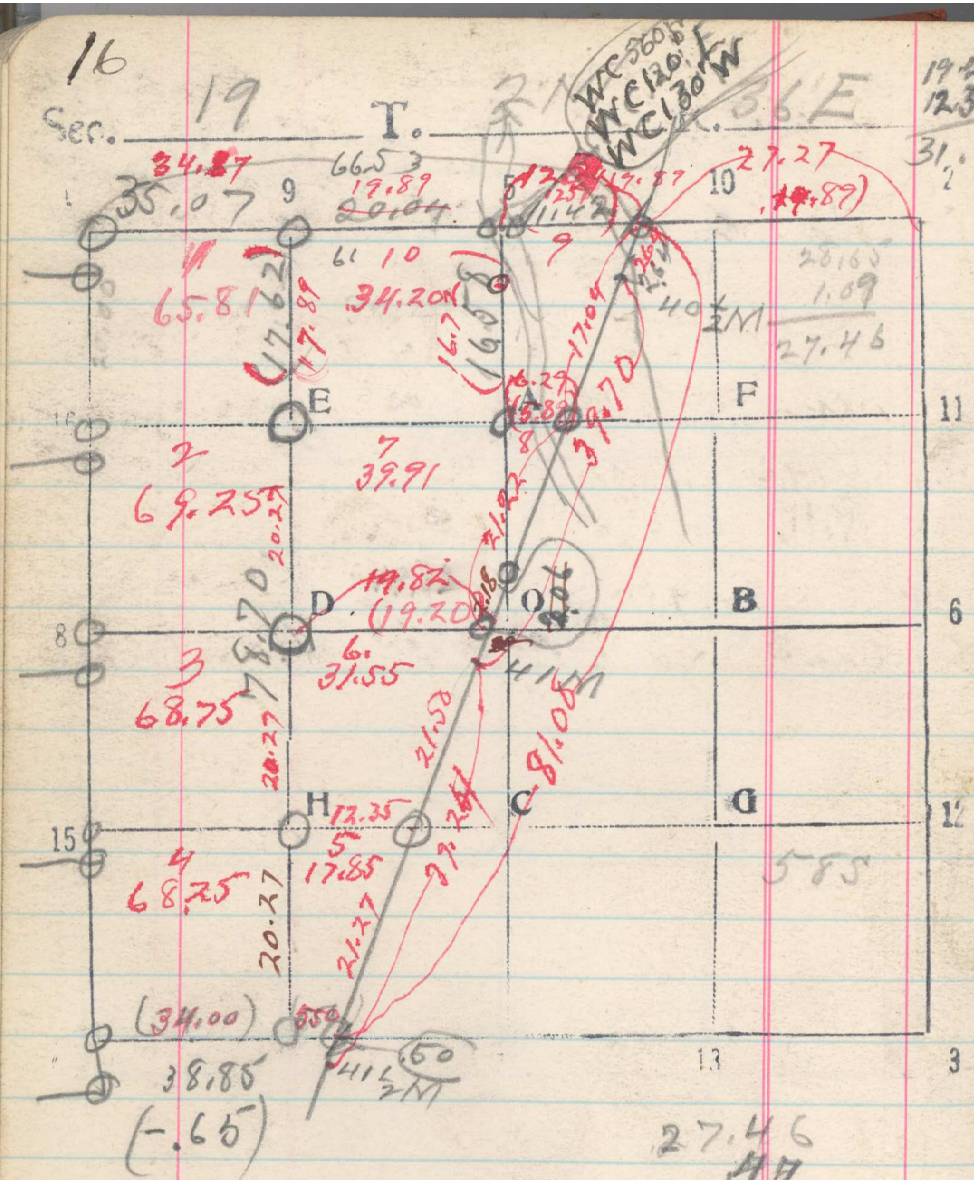

27.46
.47
27.00

From point on Res bdy 1.26 chs N 20° E of 40½ M cor run S 86° 24' E by solar

27.46 Cor of secs 17, 18, 19 & 20 bears N 288 lks. A stone with 3 Bearing trees NE, NW & SW.

From cor of secs. 17, 18, 19 & 20 run S 87°45' W by solar line

(27.27) 27.37 ~~27.60~~ (27.46 + 14 lks) Intersect Res. bdy. 2.64 chs N 20° E of 40½ M cor

29.60 R.R. about NW & S 30° E.

38.30 Set flag on E bank of Meacham Creek & go to camp Dec. 1, 1919