


5
Sec. 22 T. 34 R. 35 E

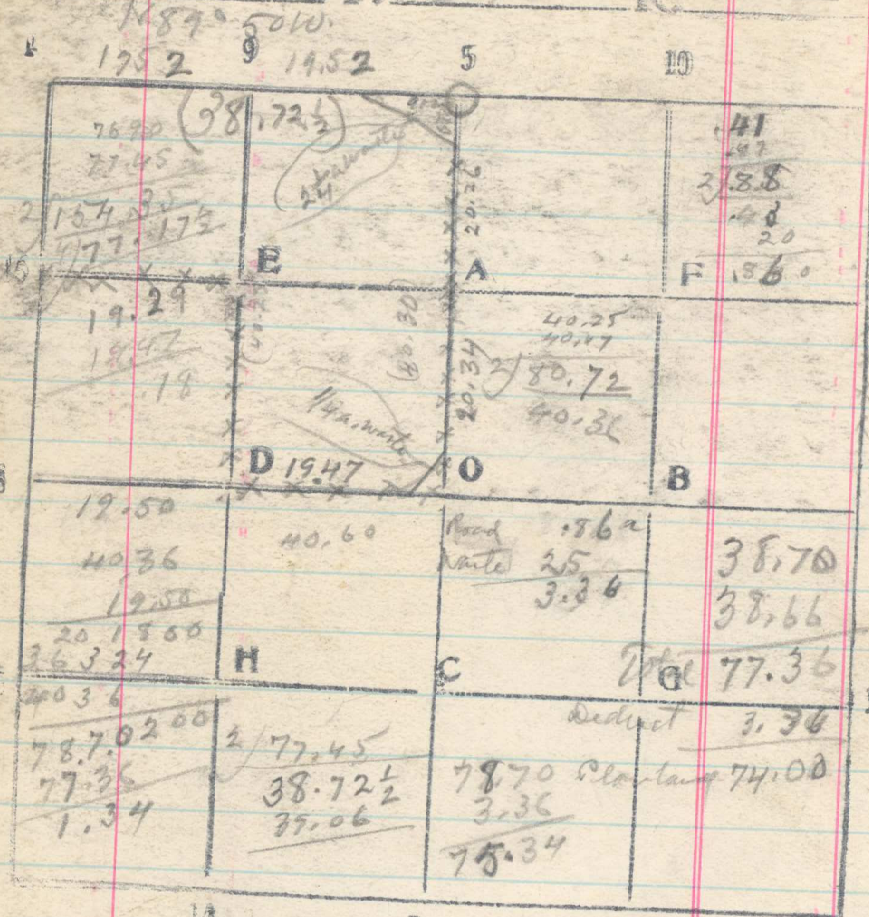

Measure South from 1/4 cor bet 15 & 22 without compen.
20.26 Fence cor. N, S, & E, Notes of 1/16 cor.
40.60 Fence cor. N & W
Thence west
19.47 Fence cor. N & E,
Thence south

20.47 Fence cor. S & W.
40.25 Fence, E & W, on S. side of road #290
1/16 cor. 9 - S. 22. (90 the line)

From 1/4 cor bet. sec. 15 & 22 near West
19.52 Online with ^{47 ch. N} fence post on S. side
of road and with ridge bet. following
to north. (Road 1/2 mile on N. side B² NW⁴)
39.04 Point for cor of sec. 15, 16, 21 & 22,
in center of road, E. W. & N.