Sec. 34 T. 1 N R. 33 E

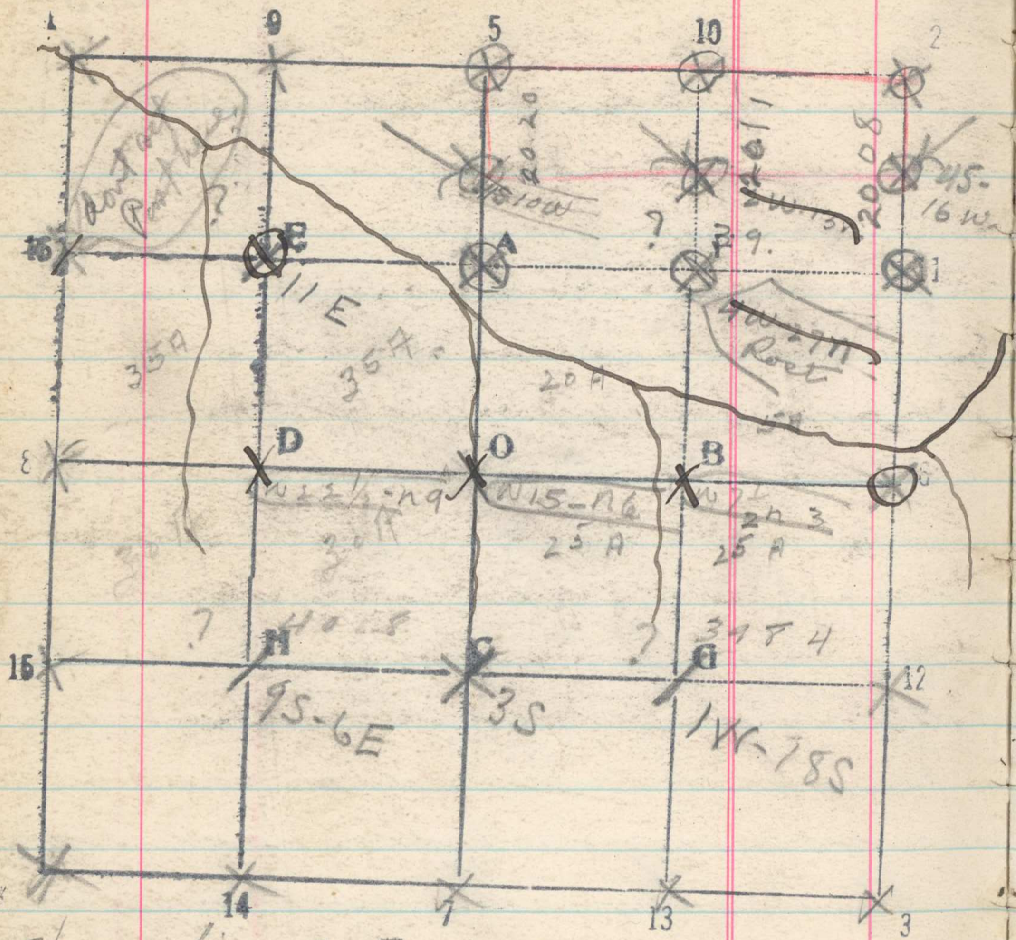

3/20 Line 5-A
10 00 Set temp cor 5-A
20.22 Cor. A bears W. 20 lks.
3/20 Line 10-F.
10 00 Set temp cor 10-F
20.36 Cor. F. bears W. 22 lks.

3/20 Line 2-11 2-11
10 00 Set temp cor 2
20.22 Cor. 11 bears W. 32 lks.

526

3/21 Line 15-11
20
40.22 1/16 Cor A on line
60.14 1/16 Cor bears S. 65 lks.
80.22 1/16 Cor 11 bears S. 54 lks.
Line 6-5
20 Set temp 1/16 cor
40.15 1/16 cor bears N. 38 lks.
60 Set temp 1/16 cor D
80.30 1/4 cor 6 bears N. 12 lks.