


Sec. 35 T. 14 N. R. 33 E.

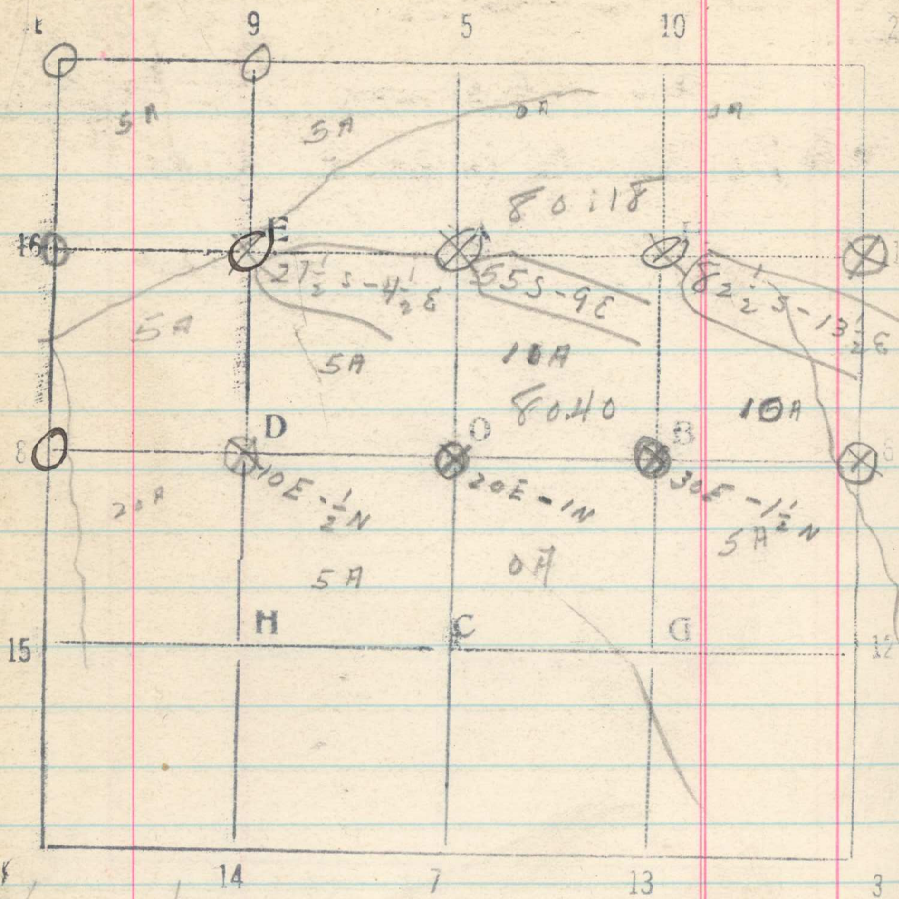

3/30 June 16 - 11
 20 Set traps cor. E
 20. Creek 5 lks. S. W.
 39.20 Traps cor. H bears S. 18 lks
 40. Set traps cor. H
 60. Set traps cor. F
 80. 18 1/16 Cor. 11 bears S. 110 lks.

3/21 June 8 - 6

20 - 40 - 60 ch. set traps cor. 528
 80.40 1/16 Cor. 11 bears N. 2 lks.