


33
Sec. 10 T. 1N R. 35E

551

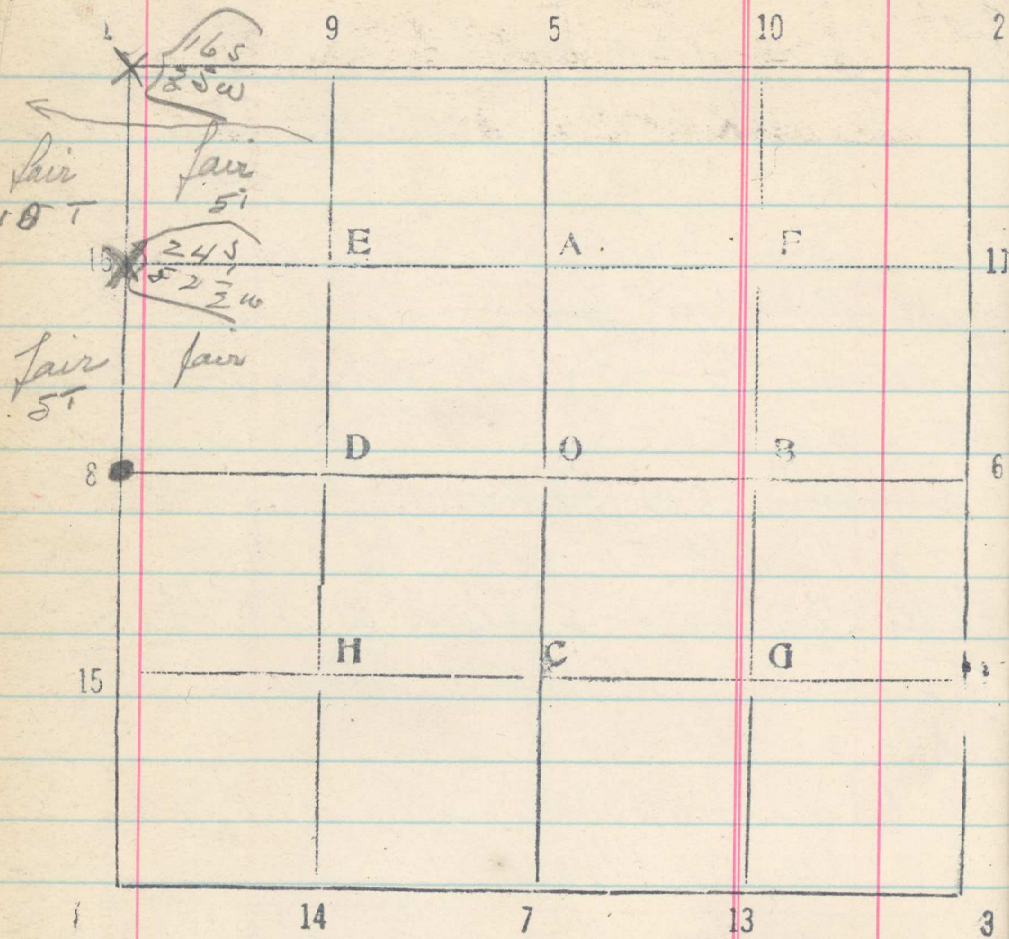

9-16 Line 1-8 South between 9+10
See under Sec. 3.