


35
Sec.

5

T. 1N

R. 25E

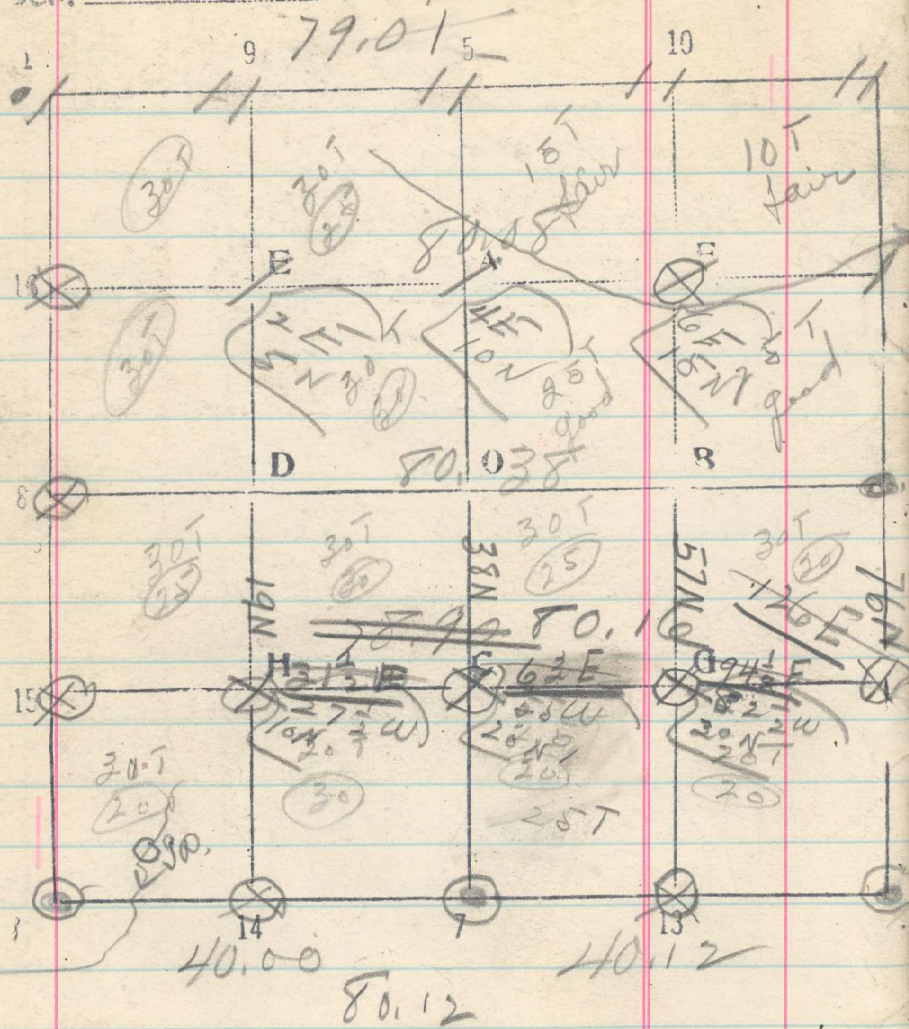

553

25/27 June 15-12 East thru North half
 Set 20-40-60
 30 Road N 30 W - S 30 E
 7.90
 80.16 1/16 cor. 12 bears N 35 W
 10/29 June 16-11 East thru North half
 11/4 Set 20-40-60
 58 Ravine Sheds S 70 E
 75 Ravine Sheds N 70 E
 80.08 1/16 cor. 11 bears N 20 W
 June 8-6 East thru Center
 Set 20-40-60
 80.38 1/4 cor bears N 8 W