


40

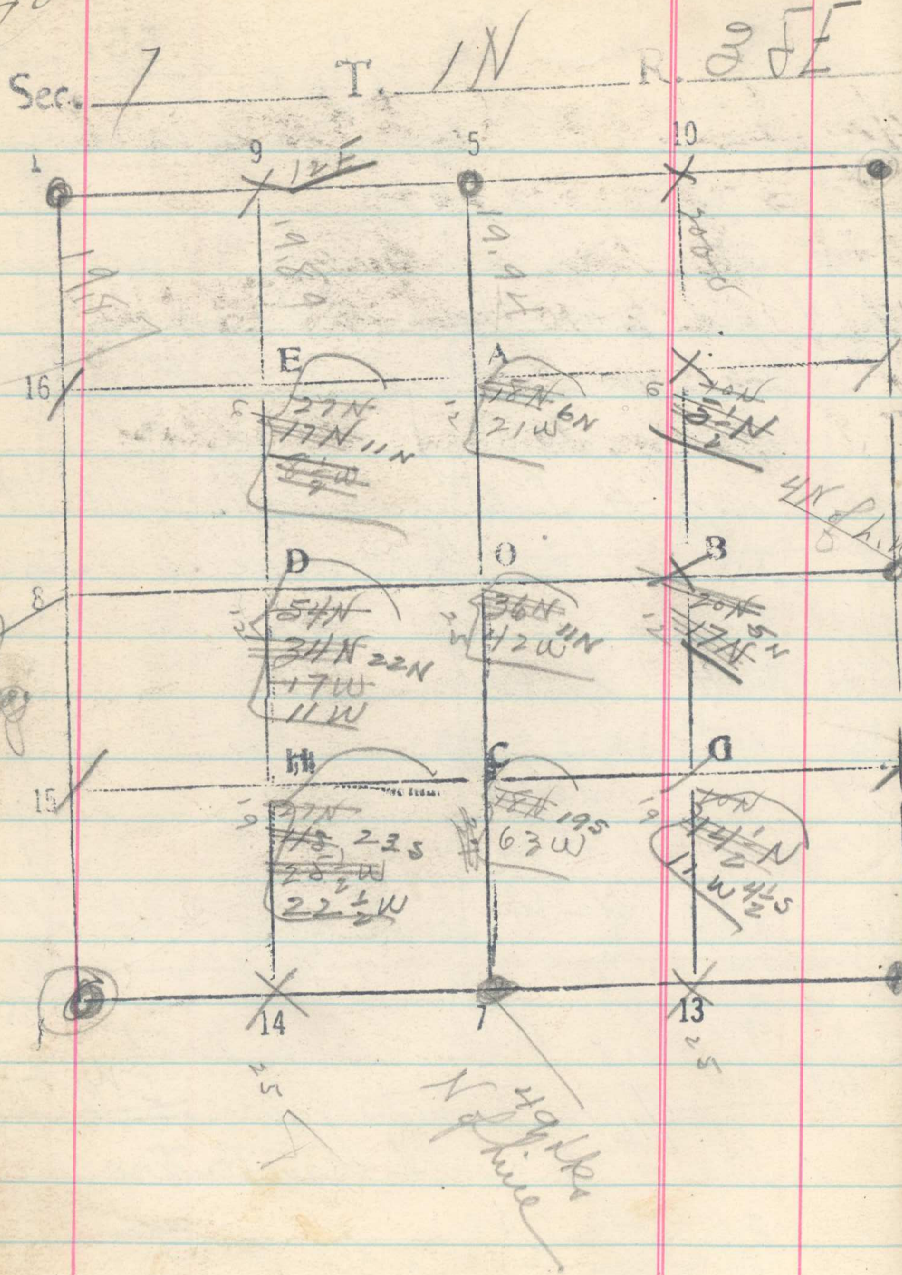

558

10/20 Line 7-3 East between 7+18

Set 5-10-15-20-

40.51 Sec. cor. on line

10/20-22 Line 13-10 North thru East half

Set 20-40-60

80.15 1/16 cor. 10 bears W. 45 lbs.