


3 line H - E West 1/2 cor 12
 40 1/2 cor E on line
 S 12 T. R.

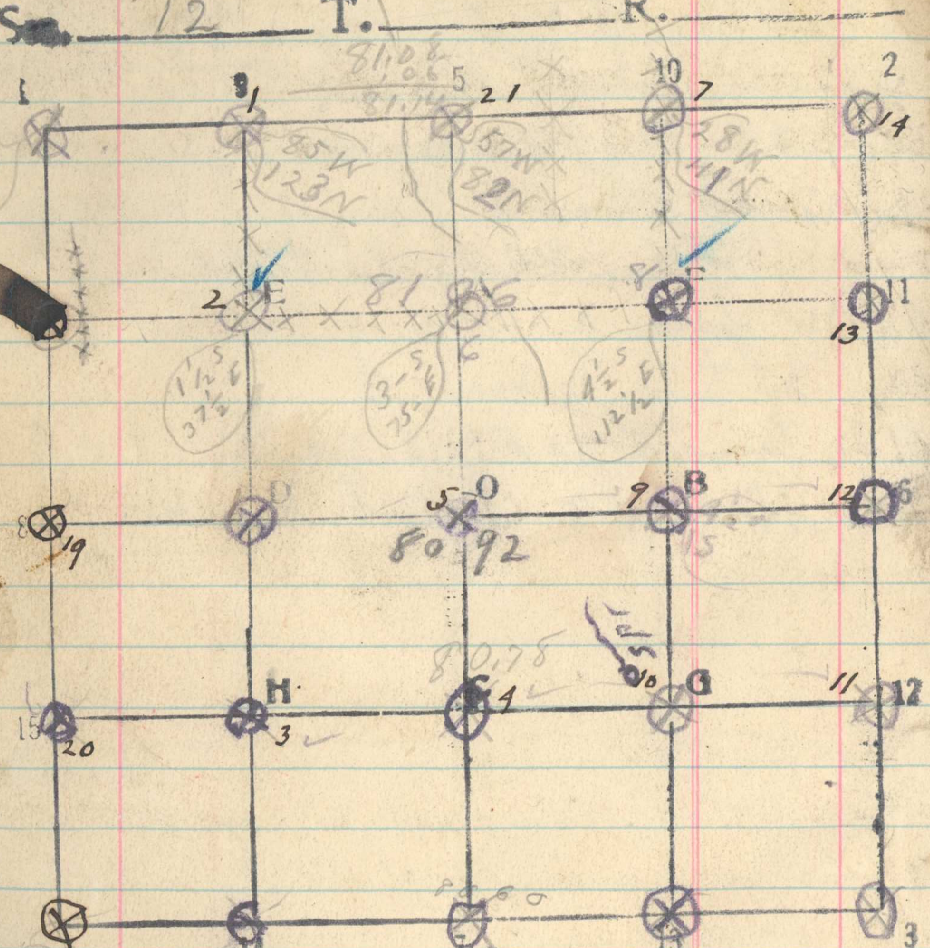

South bet sects 7 + 12
 2000 39.80 chs cor 6 bears 86 W
 Line F G 4002 chs cor G
 bears 9 lbs West

East through N 1/2 sec 12
 450 chs fence + plow ground
 19.72 leave ploughed 11
 2100 set stake 25 lbs W + 10 S of fence cor
 3500 chs cross same fence Run E + W
 4000
 4400 chs
 6000 chs fence Cor bear 22 S + 3 W
 8106 chs cor 11 bears 12 lbs South

West bet sec 12
 20 chs set stake
 2124 chs fence N + S Neal Kemler Cor bear 32 lbs N
 3086 fence N + S leave plowed ground
 40
 46
 60
 6095
 8108 chs cor 1 bears 16 lbs N
 104 after correction