


9 3  
2.00

16-11  
8-6  
11-12

340 300  
300  
540

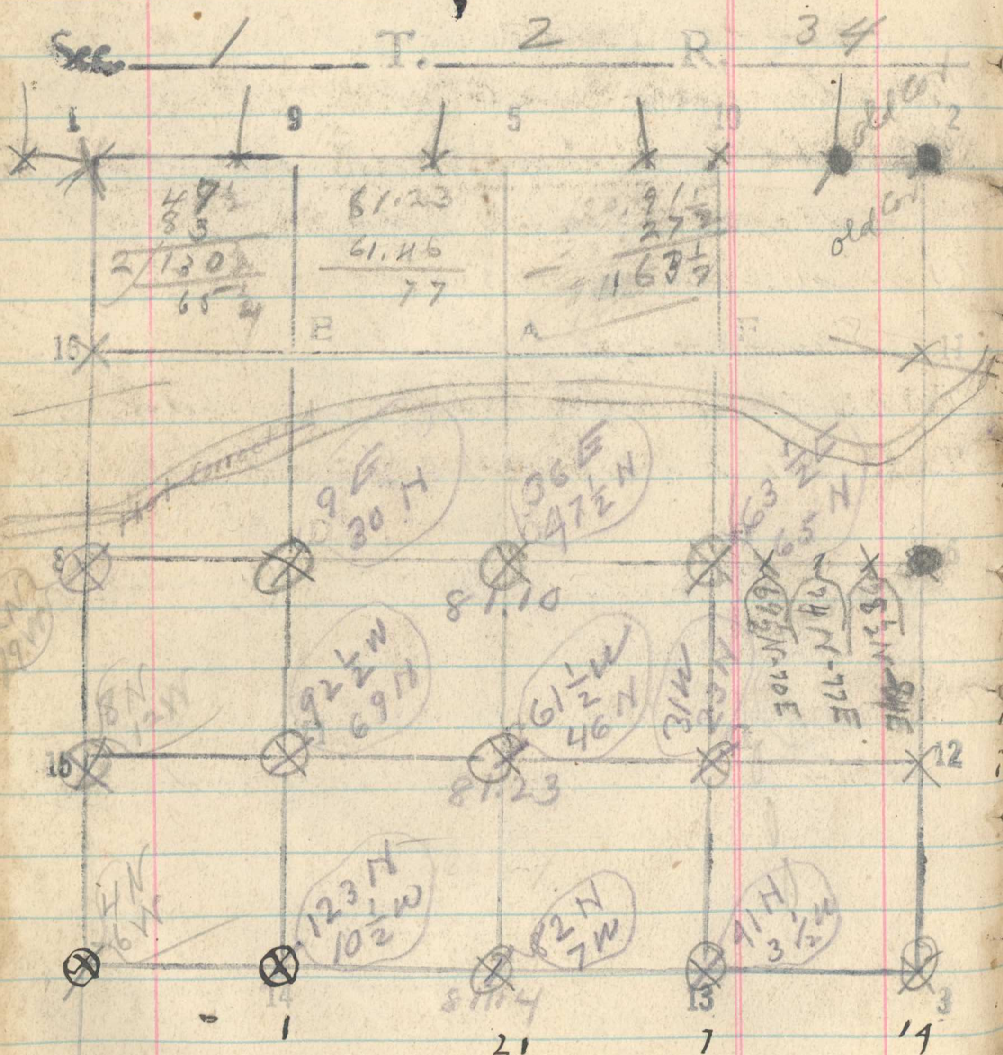

54  
27  
81

327 lbs. casing 83

East through Ct. sec 1

485  
Line 8-6

20-40-60-65-70-75

52 lbs Cross. Pendleton Pipe line

80.91 lbs cor 6 bears 83 lbs N

119  
West through South 1/2 sec 1

Line 13-15

20-40-60

61.96 lbs fine <sup>8 1/2</sup> bears 68 lbs N

81.11 lbs cor 15 bears 49 lbs N

13  
8  
81.23

North between 1 & 2 line 15-1

17.72 Road N 45 W-5458

17.87 fence N 45 W 5458.

20 set traps 1/4 cor