


Sec. 3316

T. 2N

R. 25E

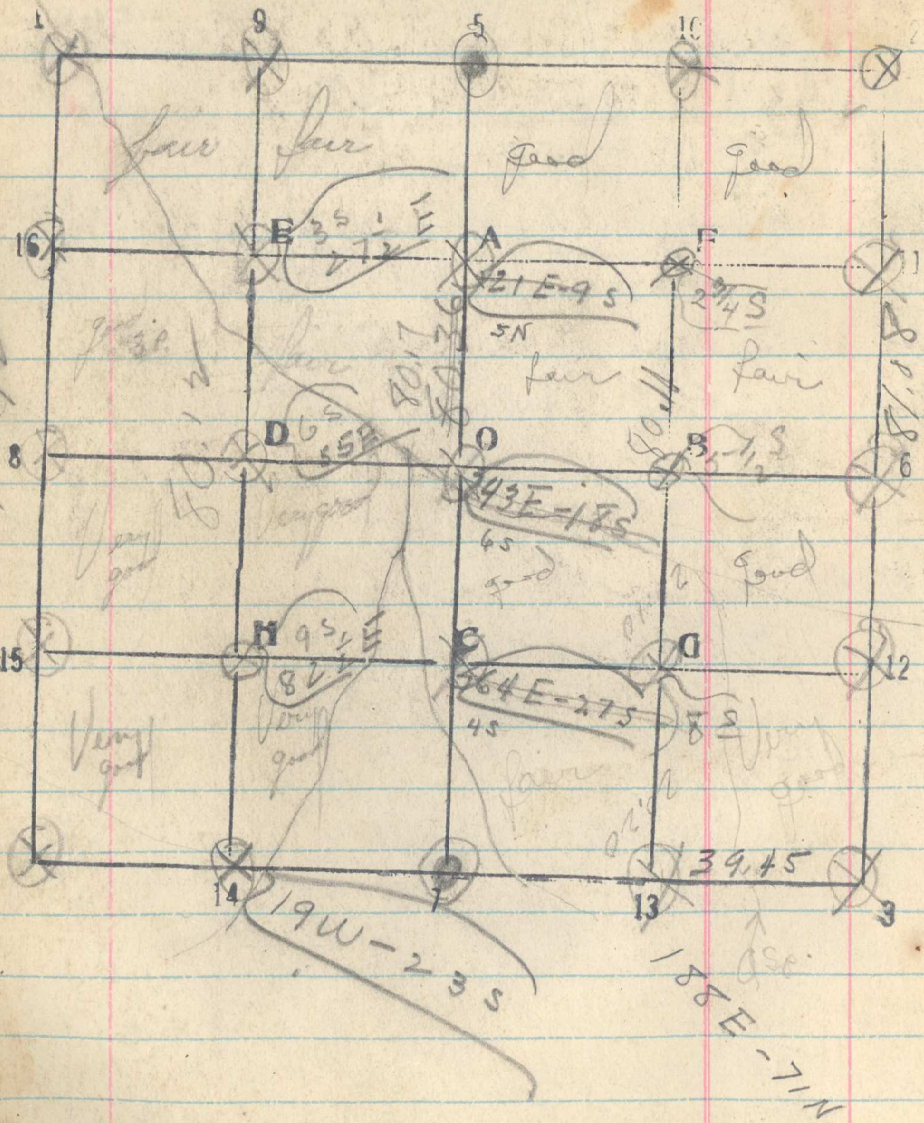

6/1 line 9-14 South thru West half
 (line = to West line of Sec 9)

509

Set 20 - 40 - 60.

30 Stage gullet Sheds N 30 W.

80.12 1/16 Cor. 14 hours E. 110 rds.

6/21 line 10/12 South thru East half
 Set 20 - 40 - 60

45 Stage gullet Sheds N 70 W.

80.11 1/16 Cor. 7 on line.