


12
 Sec. 25 T. 2N R. 35 E

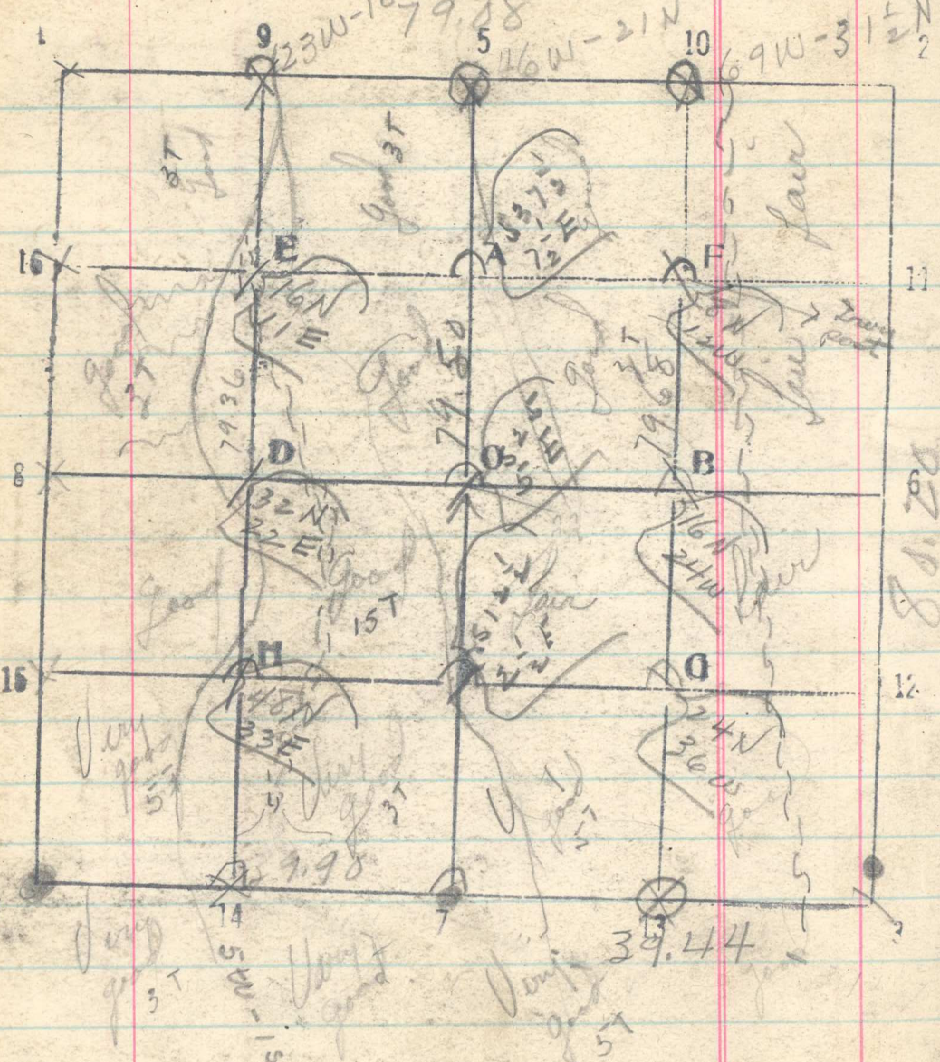

6/4 Line 10-13 South from East half.
 let 20-40-60
 79.68 1/4 cor 12 bears W. 48 1/2 kts

6/20 Line 4-7 East between 25 and 26

let 20
 39.90 1/4 cor bet 25 & 26 bears S. 2 kts.

6/20 Line 7-3 East from 1/4 cor bet 25 & 26

Set 20
 8 Ravine Sheds North

35 Ridge N. S. 39.44 c.c. Bears N 10 kts.
 40.50 Set stake No sign clearing corner

6/25 Line 1-2 East between 24-25

let 20-40-60 / No sign 1/4 cor
 21 Ravine Sheds N. 30 E Ridge

80 Set temp clearing cor. No sign 1/4 cor
 79.08 C. C. 24+25 bears N 4 1/2 kts.

7/28 Line 9-14 South from West half

let 20-40-60
 8 Ravine Sheds N. 30 E

45 Ravine Sheds N 20 W 56 Ravine Sheds NE
 79.36 1/4 cor 14 bears E 4 1/2 kts

7/28 Line 7-5 North from center
 let 20-40-60
 79.50 1/4 of 24+25 bears E 10 kts.