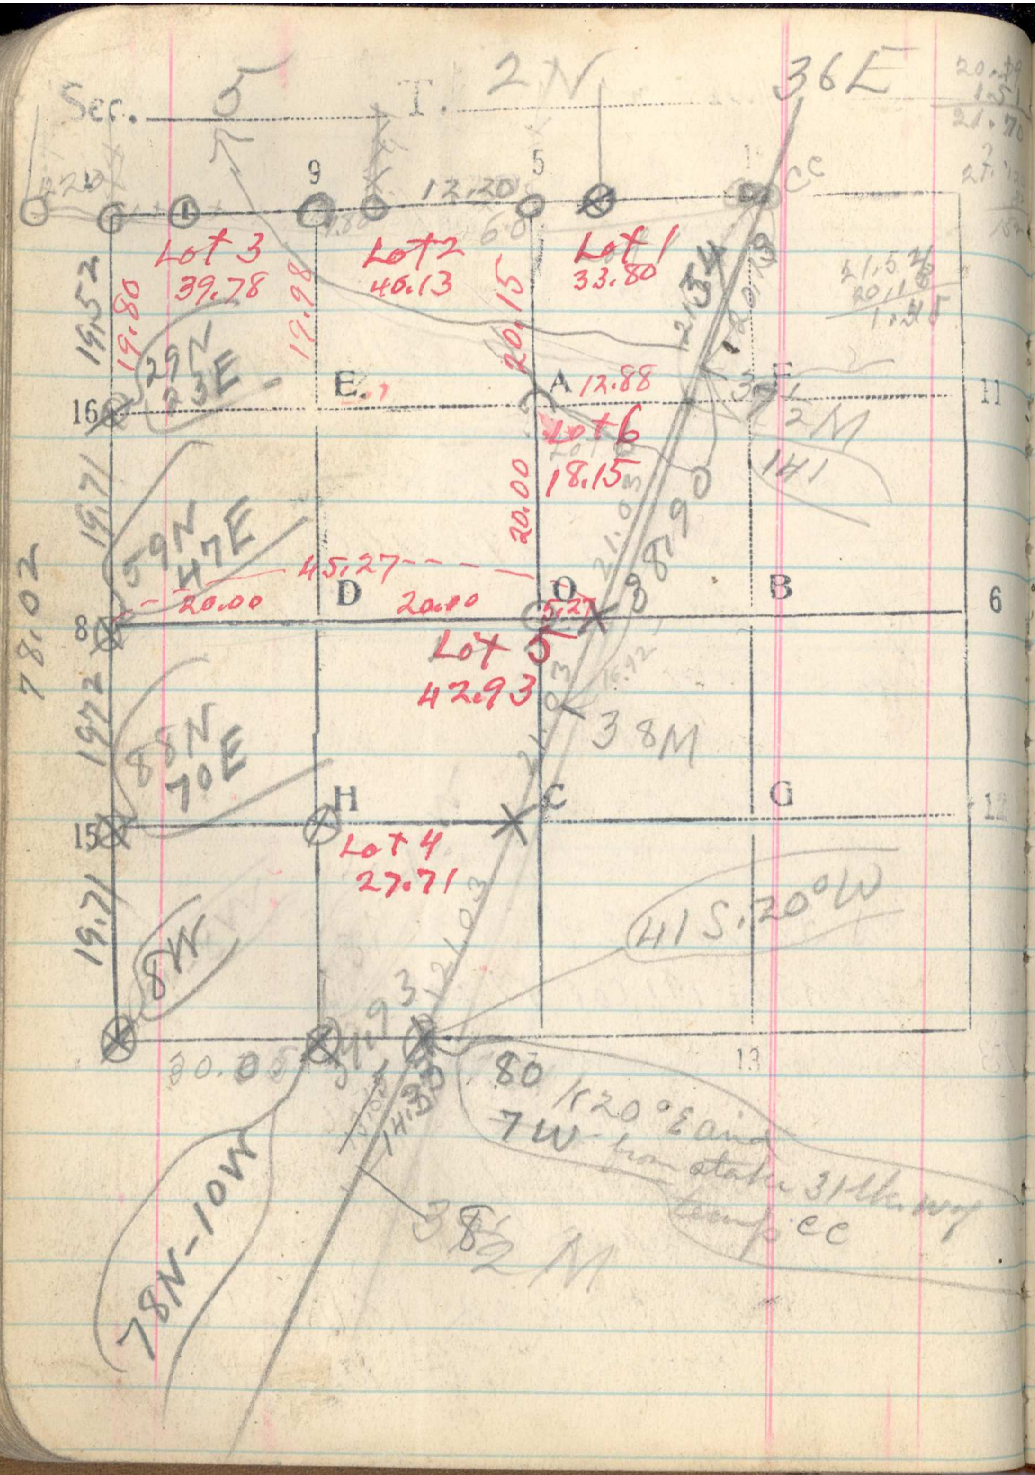

Thursday Dec 4th 1919

from 38 Mile Corner I run
N 20° E on Res Bdy
ascend on steep rocky South Slope
1500 chs top long ridge Slopes E & W

3820 chs ravine sheds west
3890 chs 37½ mile Post bears 78 lks E

from 40½ Mi Cor to 40 Mi Cor	38.25	chs
from 40 Mi Cor to 39½ Mi Cor	38.34	chs
from 39½ Mi Cor to 39 Mi Cor	39.00	chs
" 39 Mi Cor to 38½ Mi Cor	39.30	chs
" 38½ Mi Cor to 38 Mi Cor	39.93	chs
" 38 Mi Cor to 37½ Mi Cor	38.90	chs

3890
3993
3930
3048
7) 148.61
~~21.23~~

148.61
1.41
7) 147.20
21.03 OK