


Sec. 17 T. 34 N R. 25 E

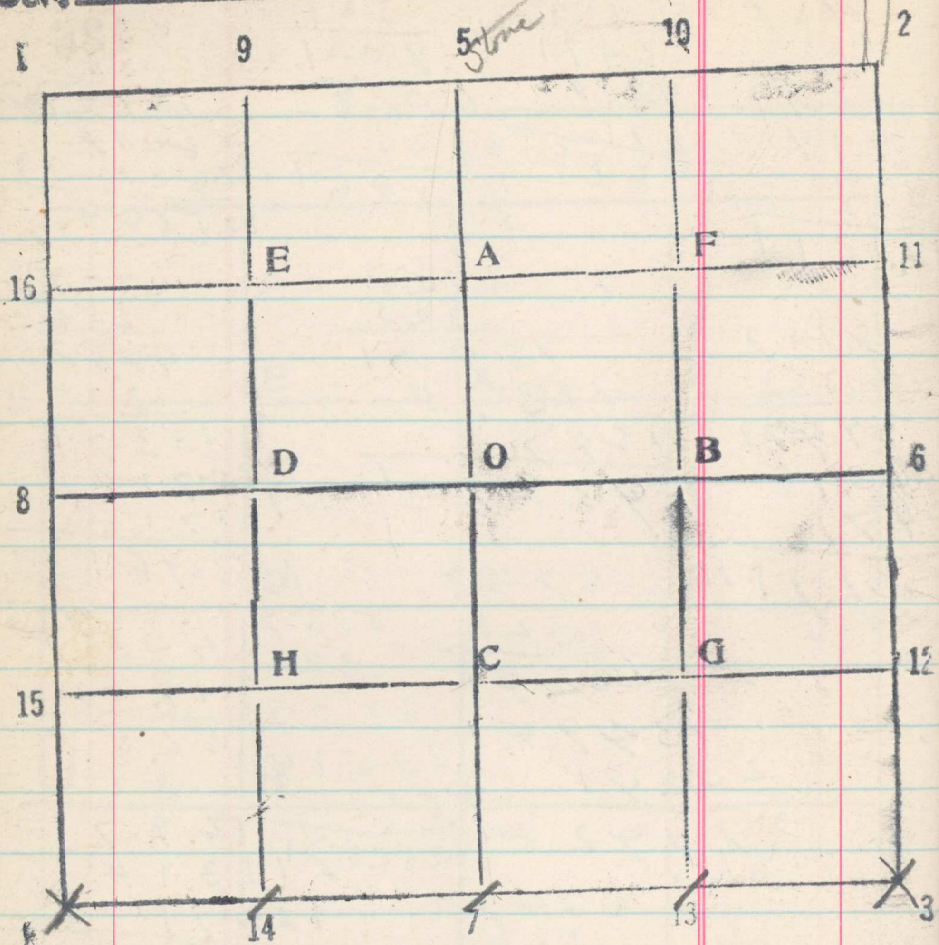

427