


22
 Sec. 26 T. 3 N. 20 N. R. 25 E

540

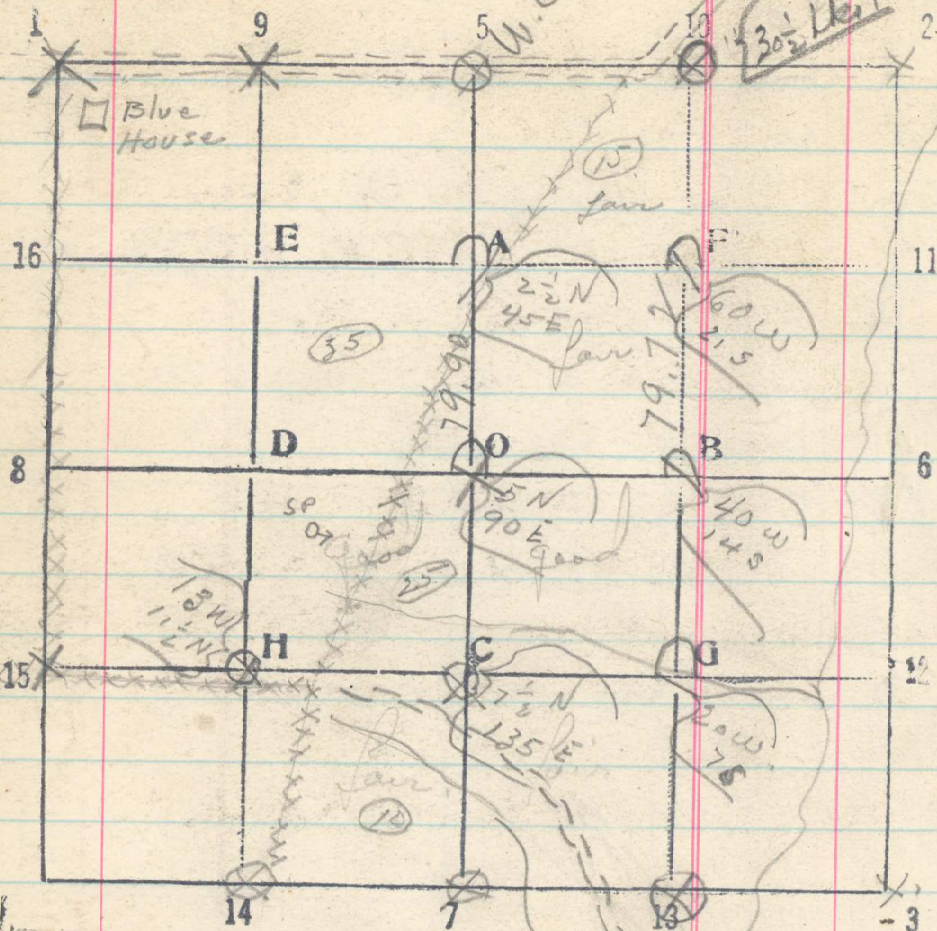

7/15 June 5-7 South thru center
 Sit 20 - 40 - 60
 21.59 Run N 45 E - S. 30 W.
 40.58 Old mound near W. 89 lbs
 79.90 1/4 cor. near E 180 lbs
 7/15 Line e - 15
 Sit 20
 1340 Line N 30 E S 10 W.
 40.26 1/16 cor 15 near N 23 lbs
 7/15 Line 13 - 10 North thru East half.
 Sit 20 - 40 - 60
 20.25 Payne shd. S 70 E.
 79.72 1/16 cor 10 near W. 80 lbs