


27

Sec. 16 T. 2 N R. 36 E

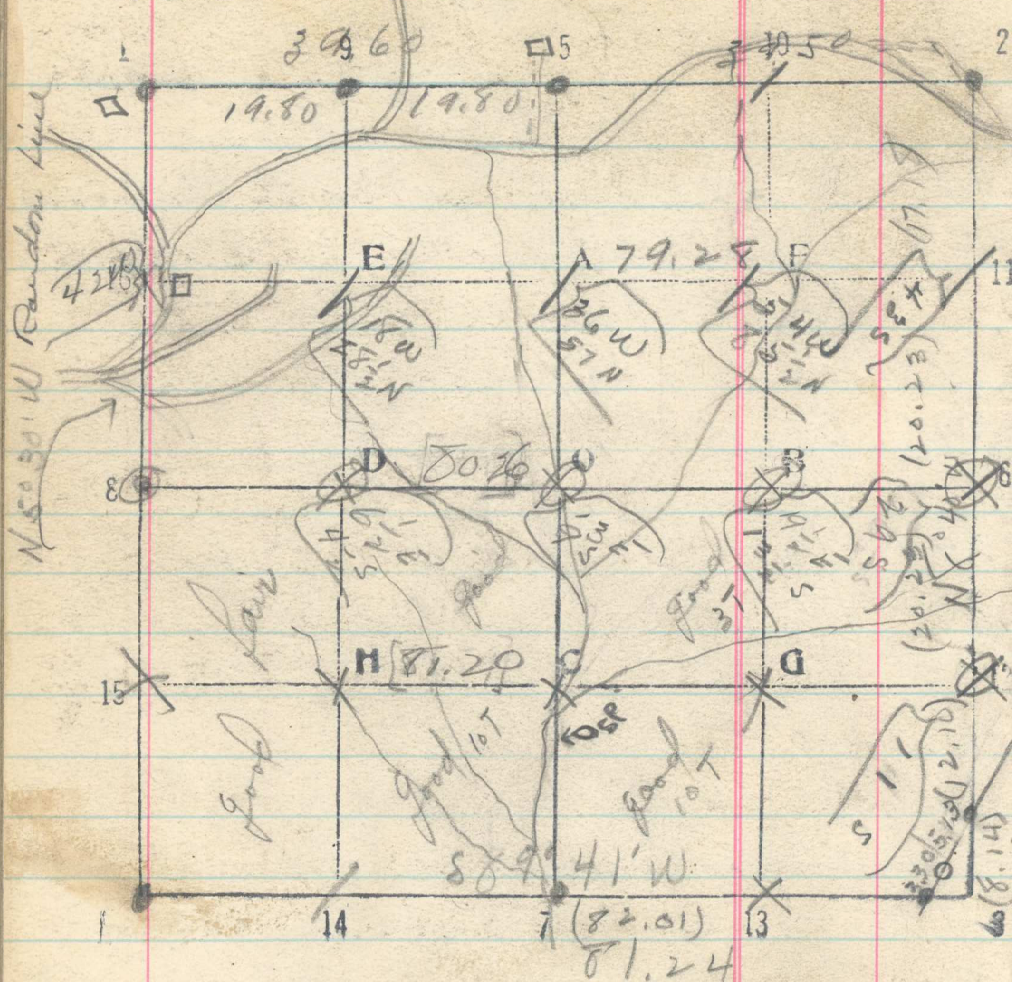

- 545
- 8/5 Line 3-2 N. 80 40 W. c.c. between 6+15
 passing from right at c.c. of 21+16 on line 16+17+20+21
 Set 12.10 - 32 33 - 52.56 - 62.56
 (No sign of 40 ft)
 19 Ravine Sheds W - 27 Ravine Sheds S 70 W.
 57.50 Ravine Sheds S 70 W. 66. Road NW - S 70 E
 69.18 See over 9 - 10 - 15 - 16 on line.
 76 Line 16 - 11 East Three North half.
 Set 5 - 10 - 15 - 20 - 25 - 30 - 40 - 60
 6 House on line.
 Roads 5 N-S. 13 N 25 E - S 15 W. 24 N 25 SW
 35 Ravine Sheds S 15 E. 61 Ravine Sheds S 20 W
 79.28 1/16 cor 11 from south line N 11 4 hrs.
 8/7 Line 15 - 12 East Three South half
 Set 20 - 40 - 60
 17 Ravine Sheds S E.
 27 Ravine Sheds S 20 E
 42 Ravine Sheds S 20 W.
 81.20 1/16 cor. on line
 8/8 Line 8 - 6 East Three Center
 Set 20 - 40 - 60
 Ravines 25-S. E / 40 - S. 5 E / 57 - SW.
 80.26 1/4 cor. near S 18 hrs.