


Township 1 South Range 31 East Will. Mer. Oregon

31

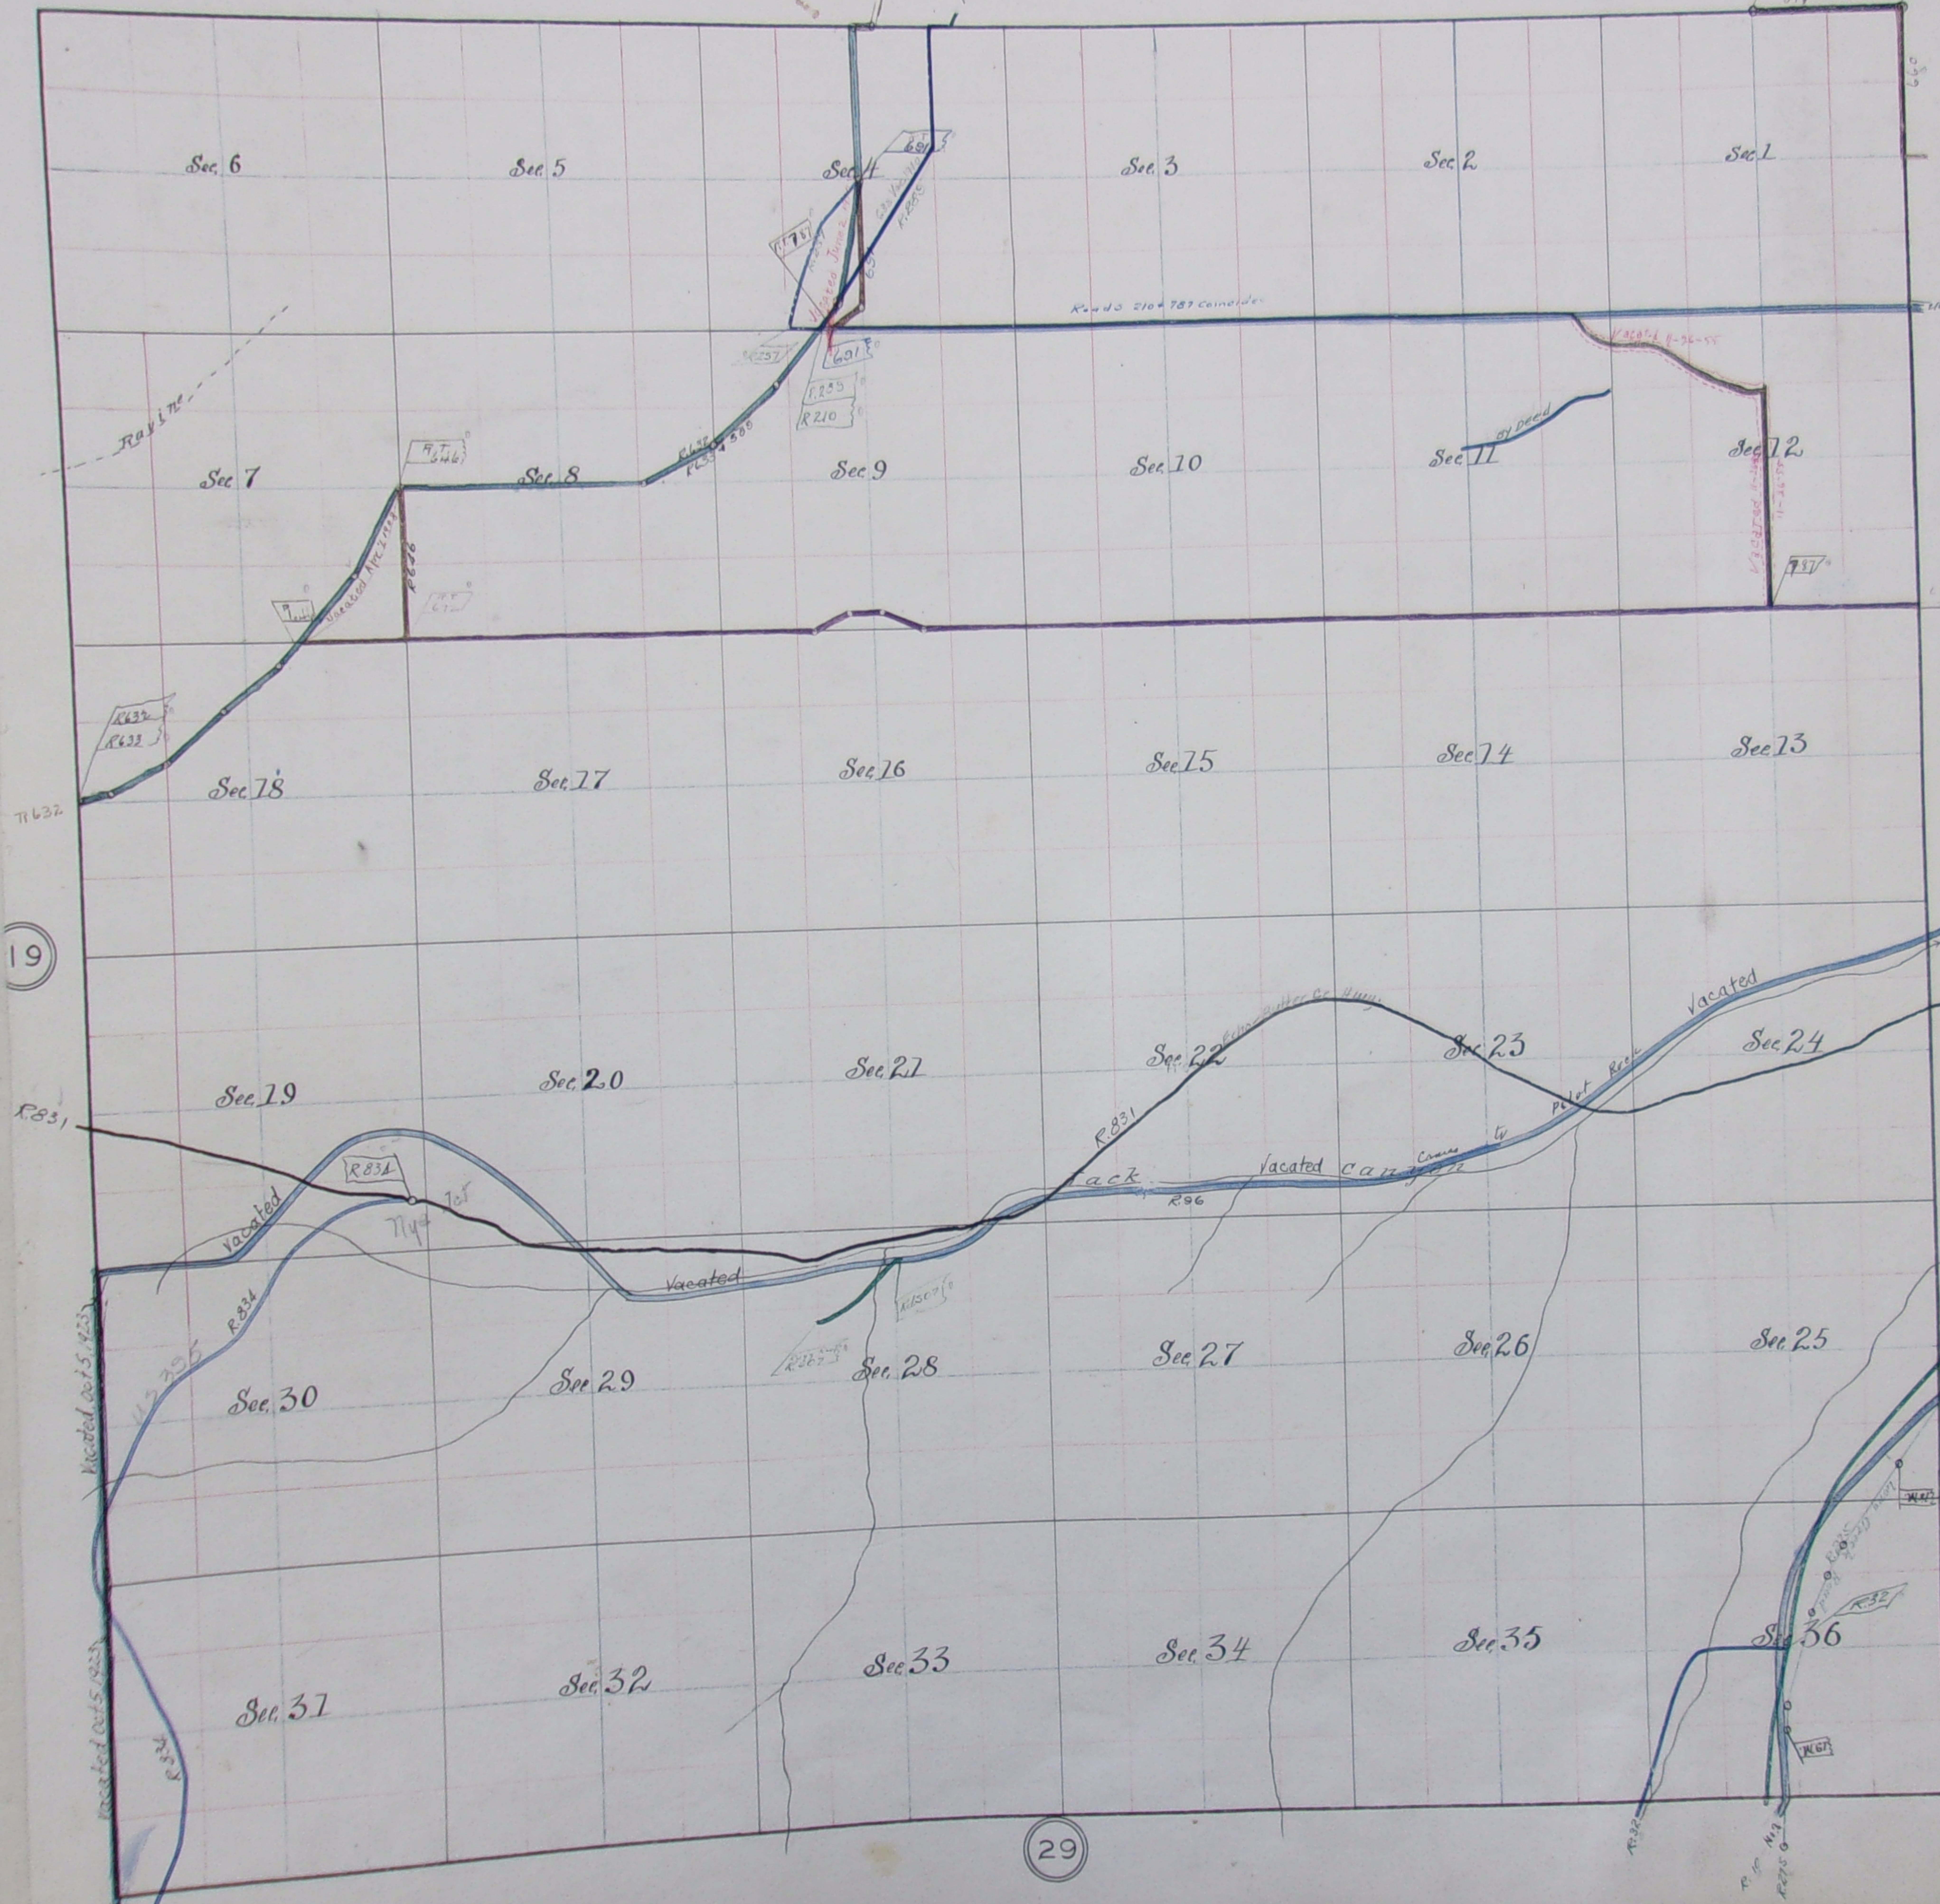

Date	No.	Box	Brk	Page	Date	No.	Box	Brk	Page
Apr 10 1854	210	76	F	571					
Nov 1850			E	70					
Apr 5 1870	189		A	614					
June 11 1907	632	561	776	172					
April 1907	233		772	270					
"	233		772	270					
Aug 7 1898	660	462	772	509					
June 2 1910	191		771	453					
June 2 1910	191		772	453					
July 10 1907	722		771	377					
May 2 1871			N	371					
Jan 26 1921	872		N	616					
Oct 5 1923	834		O	212					
July 11 1923	831								
Jan 2 1888	289								
July 15 1886	257								
Sept 3 1875	38								
Oct 7 1886	276								
Jan 1881	96								

42

19

29

True Meridian
 100' from 1812 to 1813 East

Scale 25 chains to 1 inch