


34

Township 3 North Range 31 East Will, Mer, Oregon.

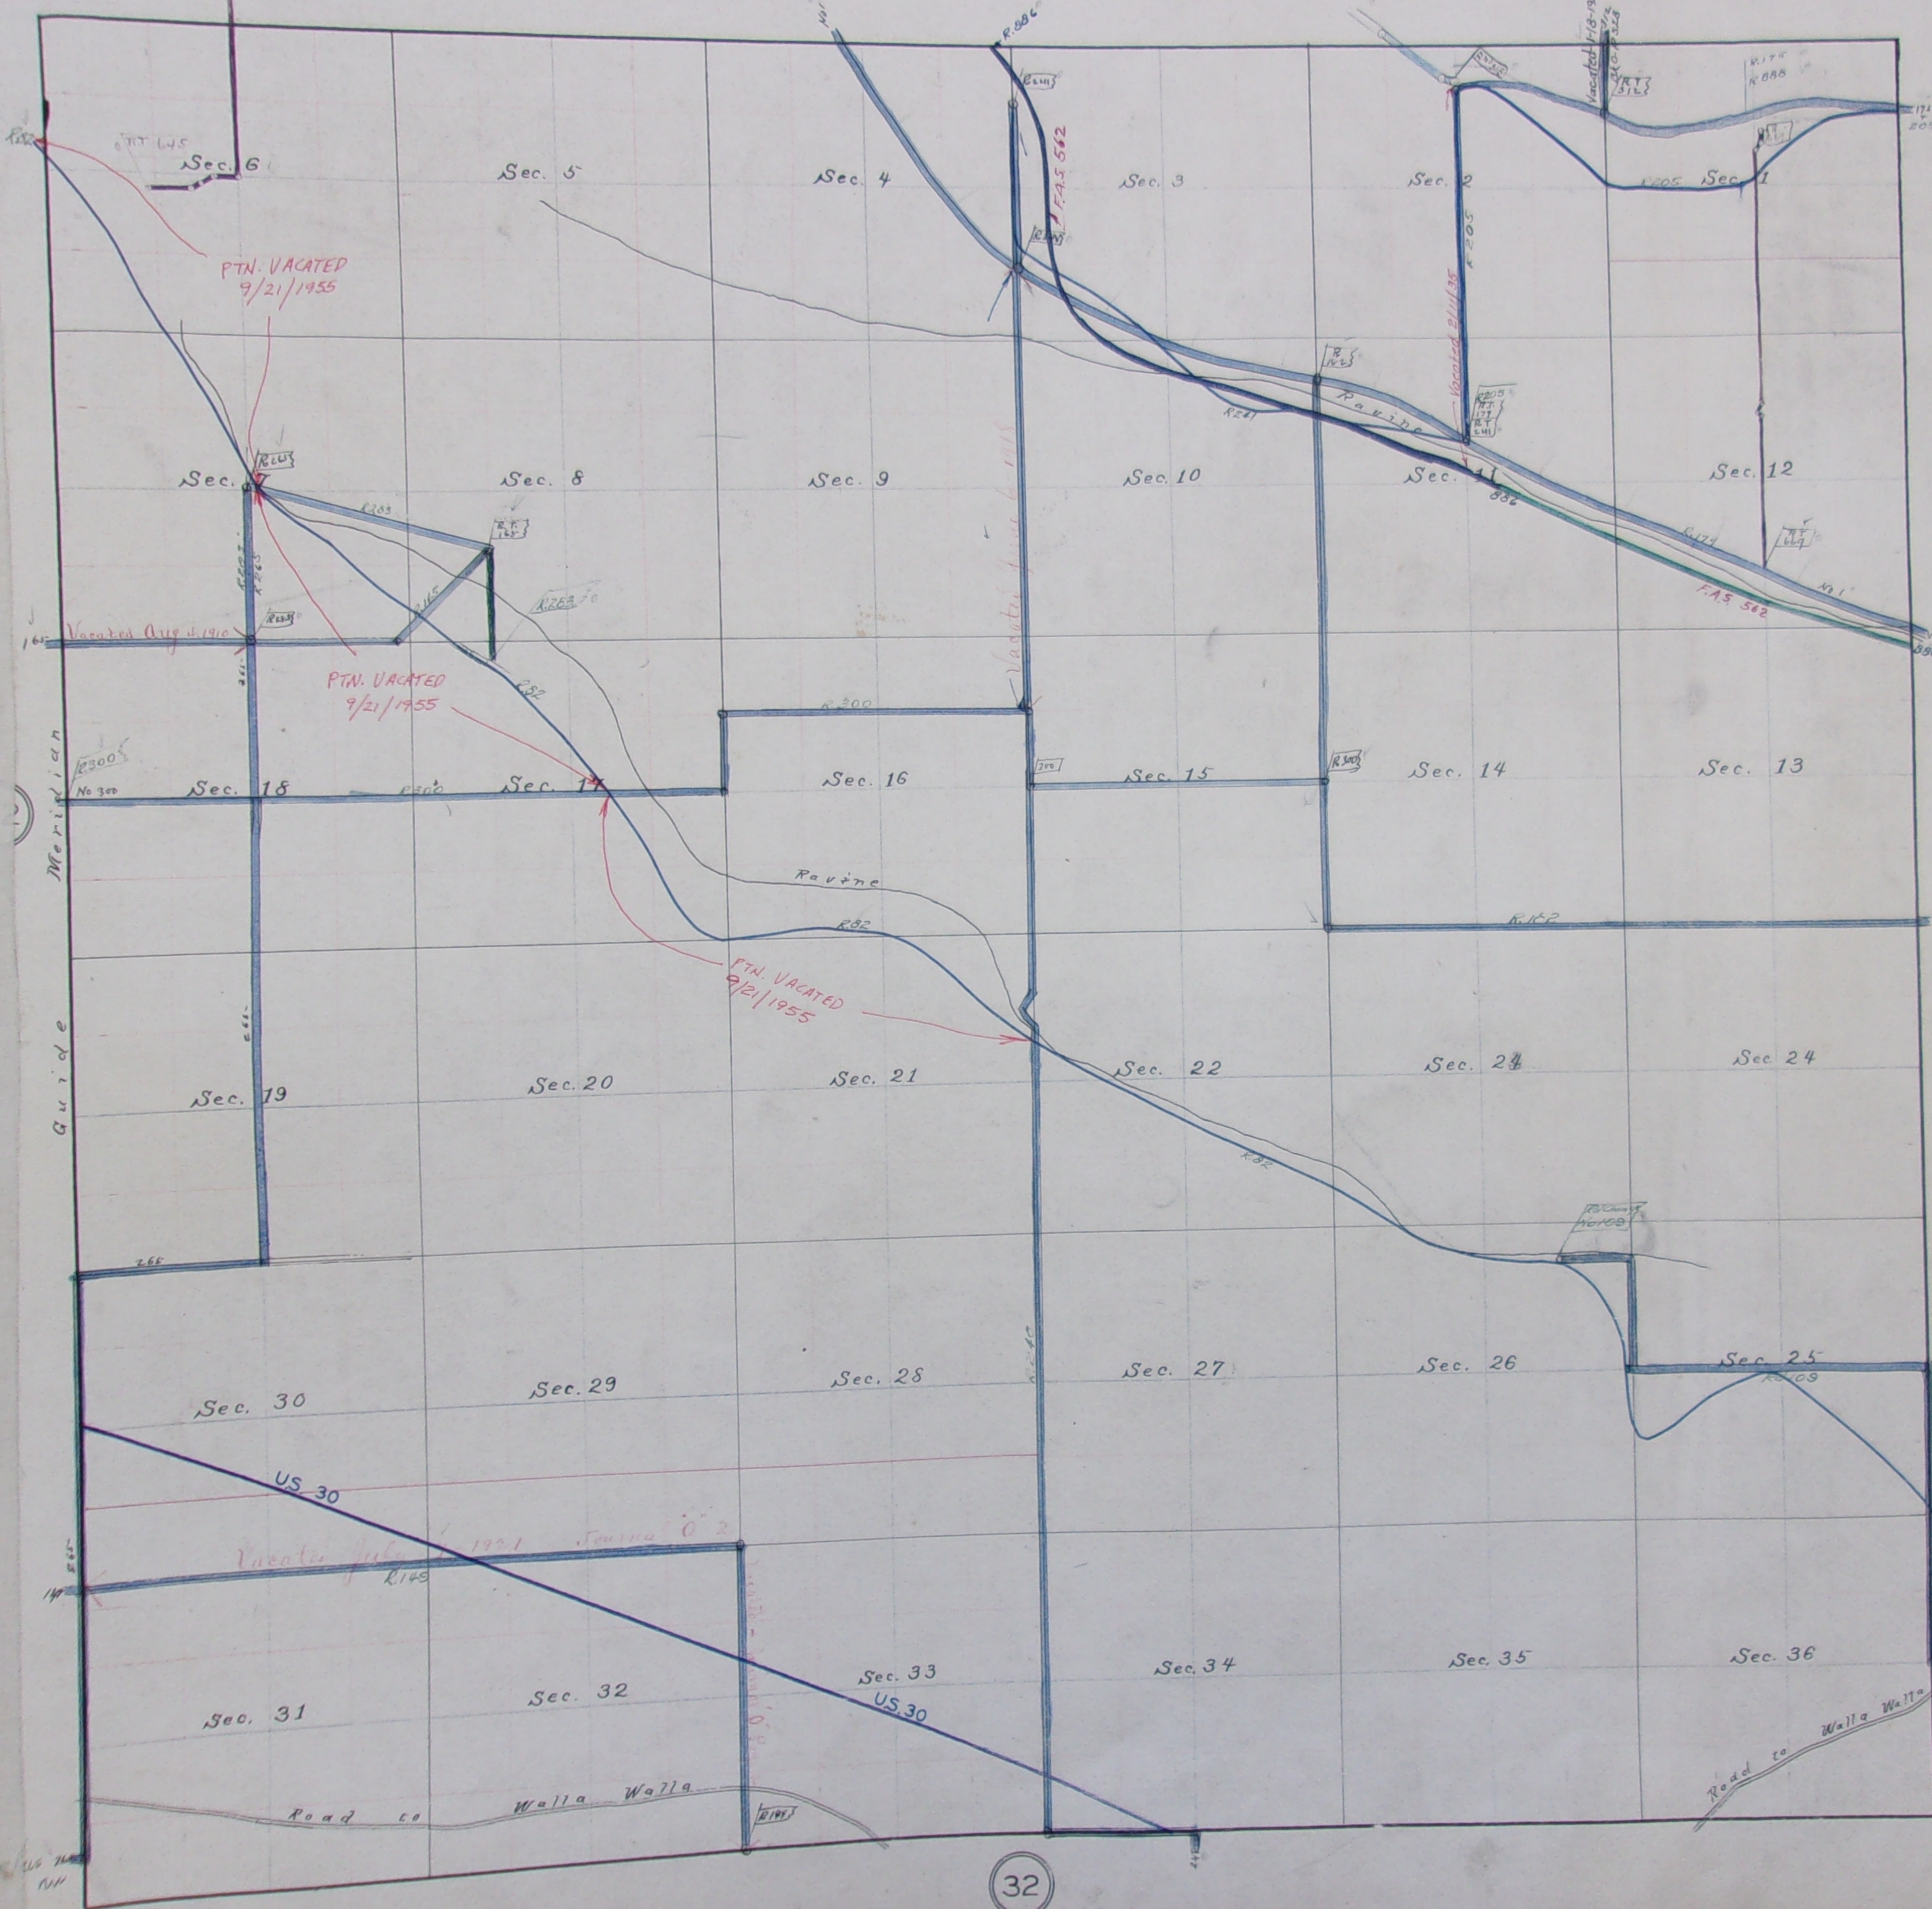

Date	No. Box	Book Page	Date	No. Box	Book Page
Sept 7 1891	300 131	Resurvey			
July 9 1888	300 129	8 11705			
Jan 11 1888	312	H 96			
Oct 6 1886	265 18	G 398			
Apr 19 1883	241 17	G 32			
July 10 1885	248	G 40			
Jan 16 1884	165 15	F 238			
Apr 10 1884	175 15	F 256			
Apr 10 1884	182 15	F 317			
July 31 1884	175 16	F 448			
July 10 1883	149 14	F 57			
Jan 24 1882	100 13	E 247			
Mar 19 1887	213 1	G 470			
Mar 1889	141	D 580			
July 7 1900	515	B 496			
Mar 6 1903	645 233	M 57			
June 8 1909	669	M 371			
Oct 4, 1929	886				
Oct 4, 1929	888				
July 21 1908	805				
Sept 1 1930	82				
Sept 21, 1955	82	U 468			

45

Scale 25 chains to 1 inch.

32