


(40)

Township 4 South, Range 32 East, Will. Mer. Oregon.

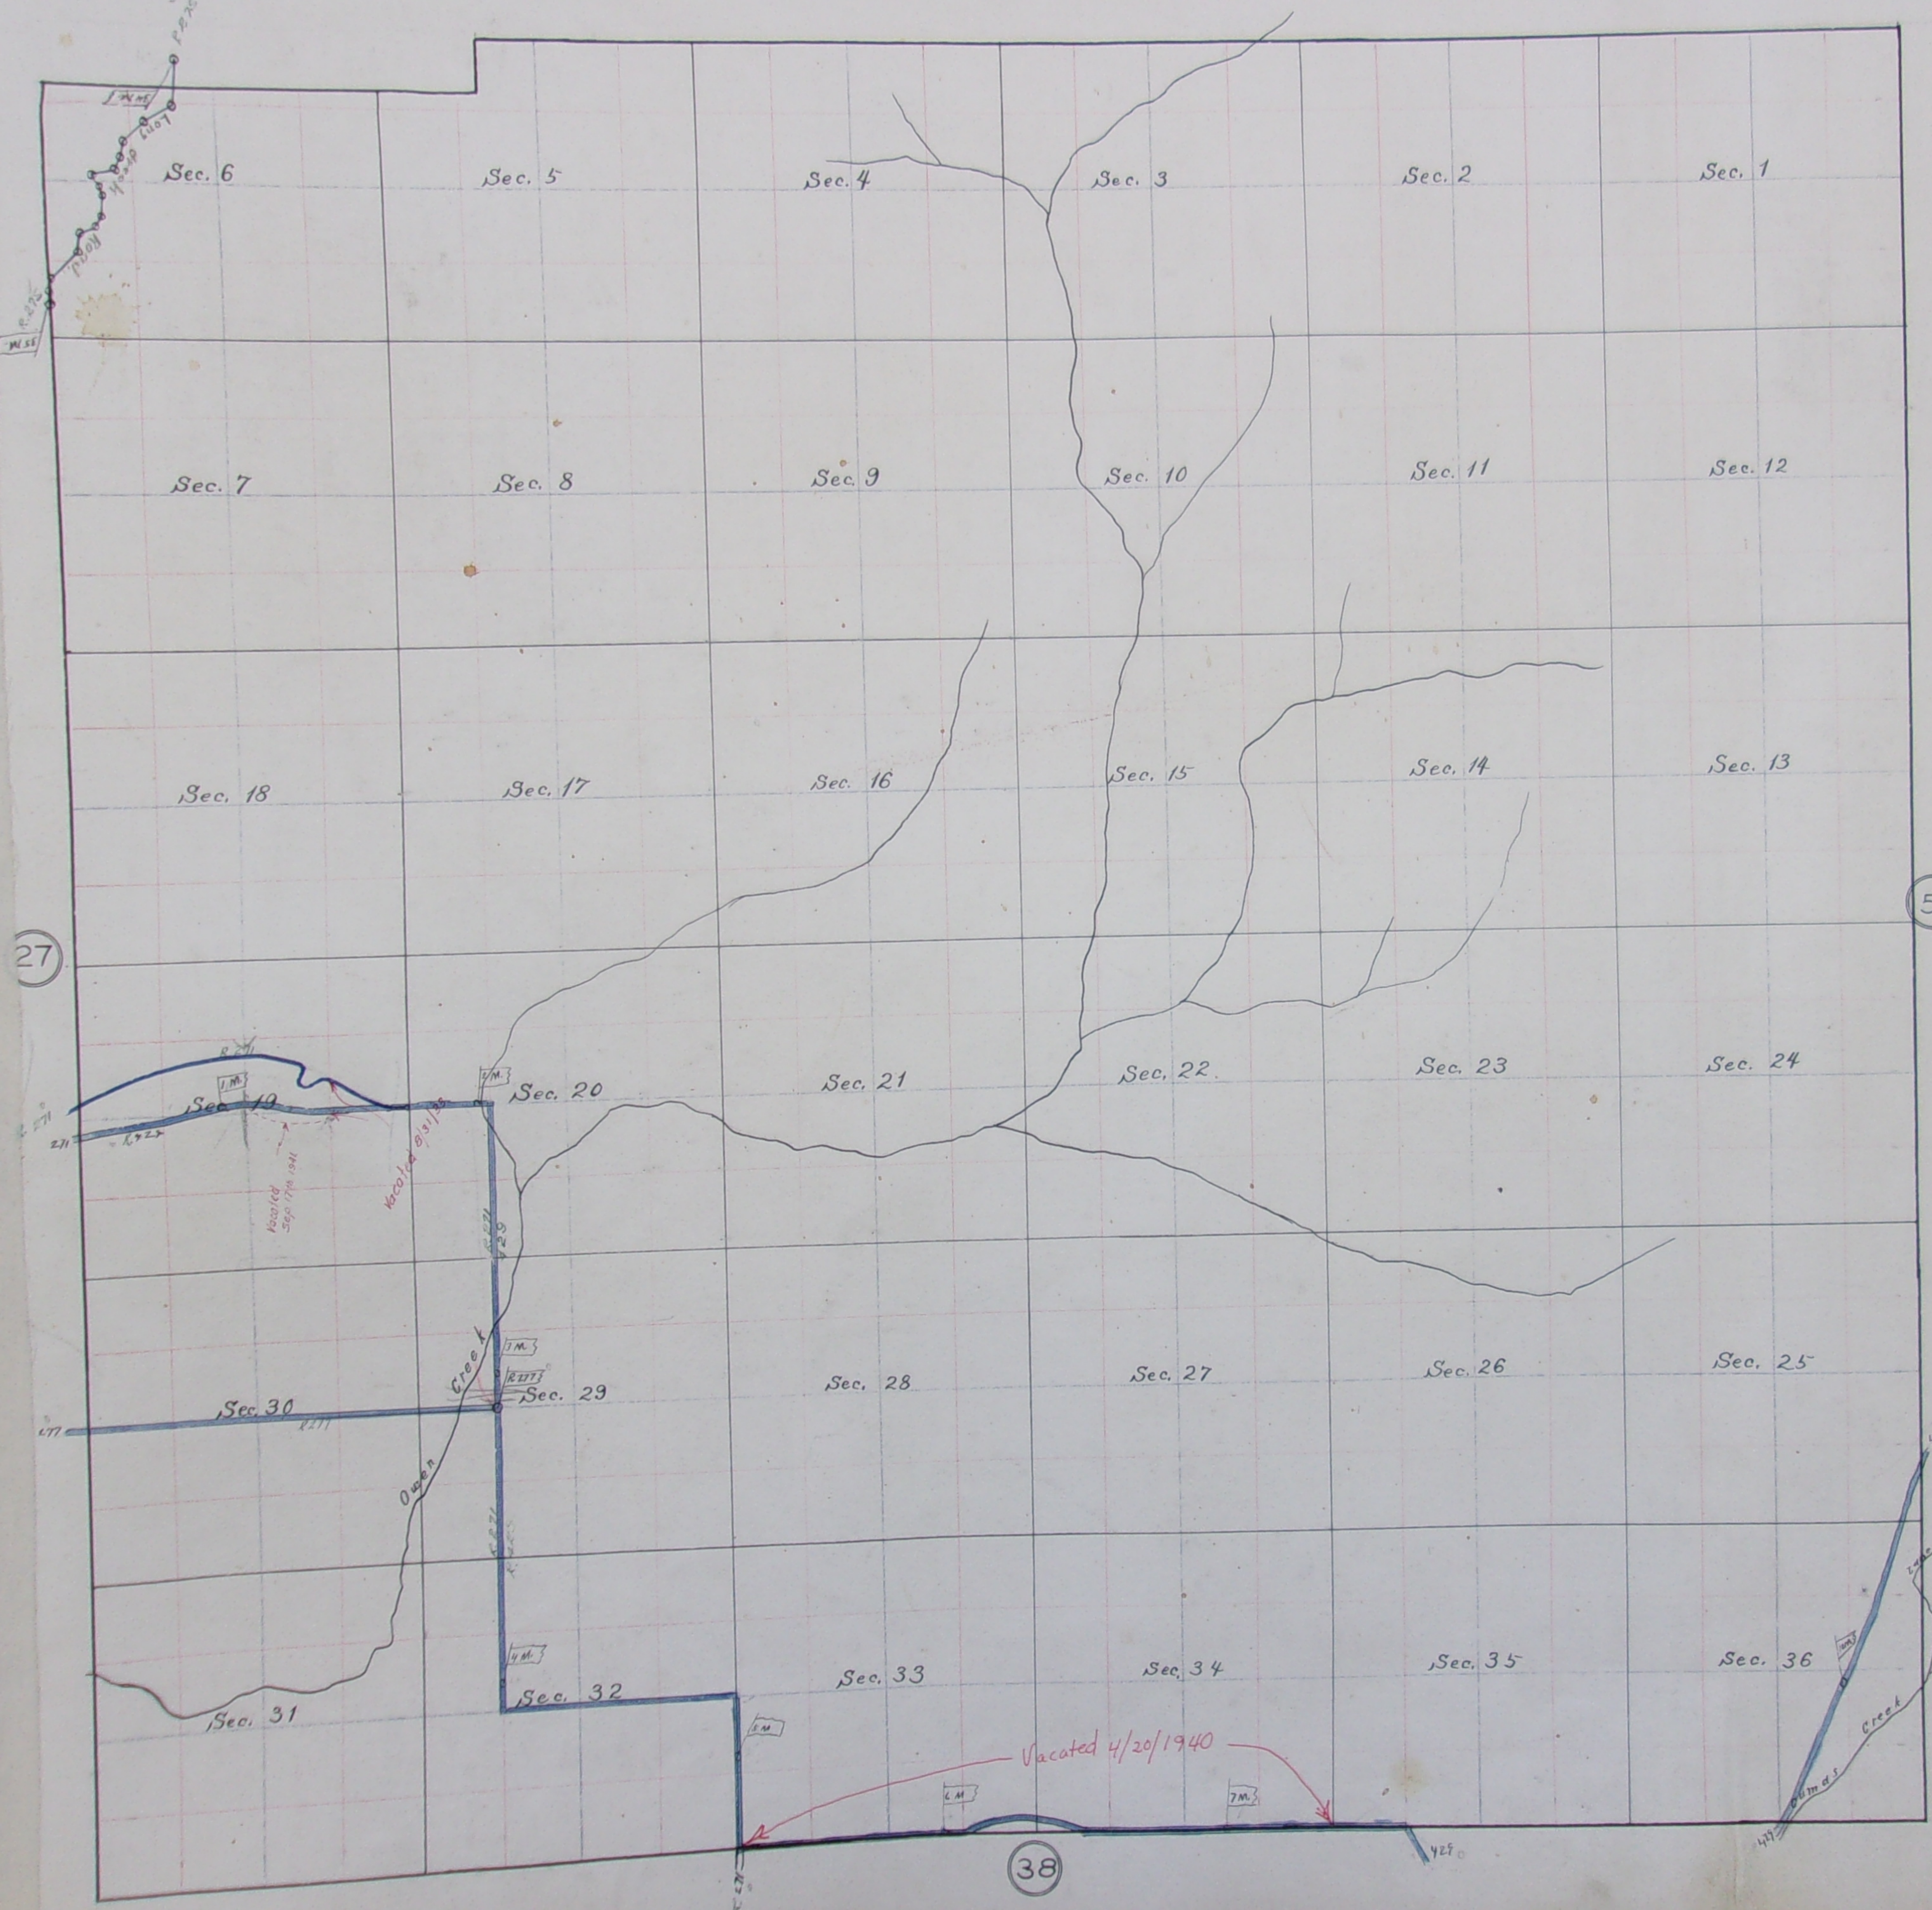

Date	No.	Box	Book	Page	Date	No.	Box	Book	Page
July 10 1893	429	131	J	539					
Jan 15 1887	277	15	G	472					
Oct 6 1886	271								
Oct 17 1886	272								
Vacated									
4/20/1940									
429									

True Meridian
 Bear. 19° 51' E

Scale 25 chains to 1 inch