


Township 3 North, Range 32 East, Will. Mer. Oregon.

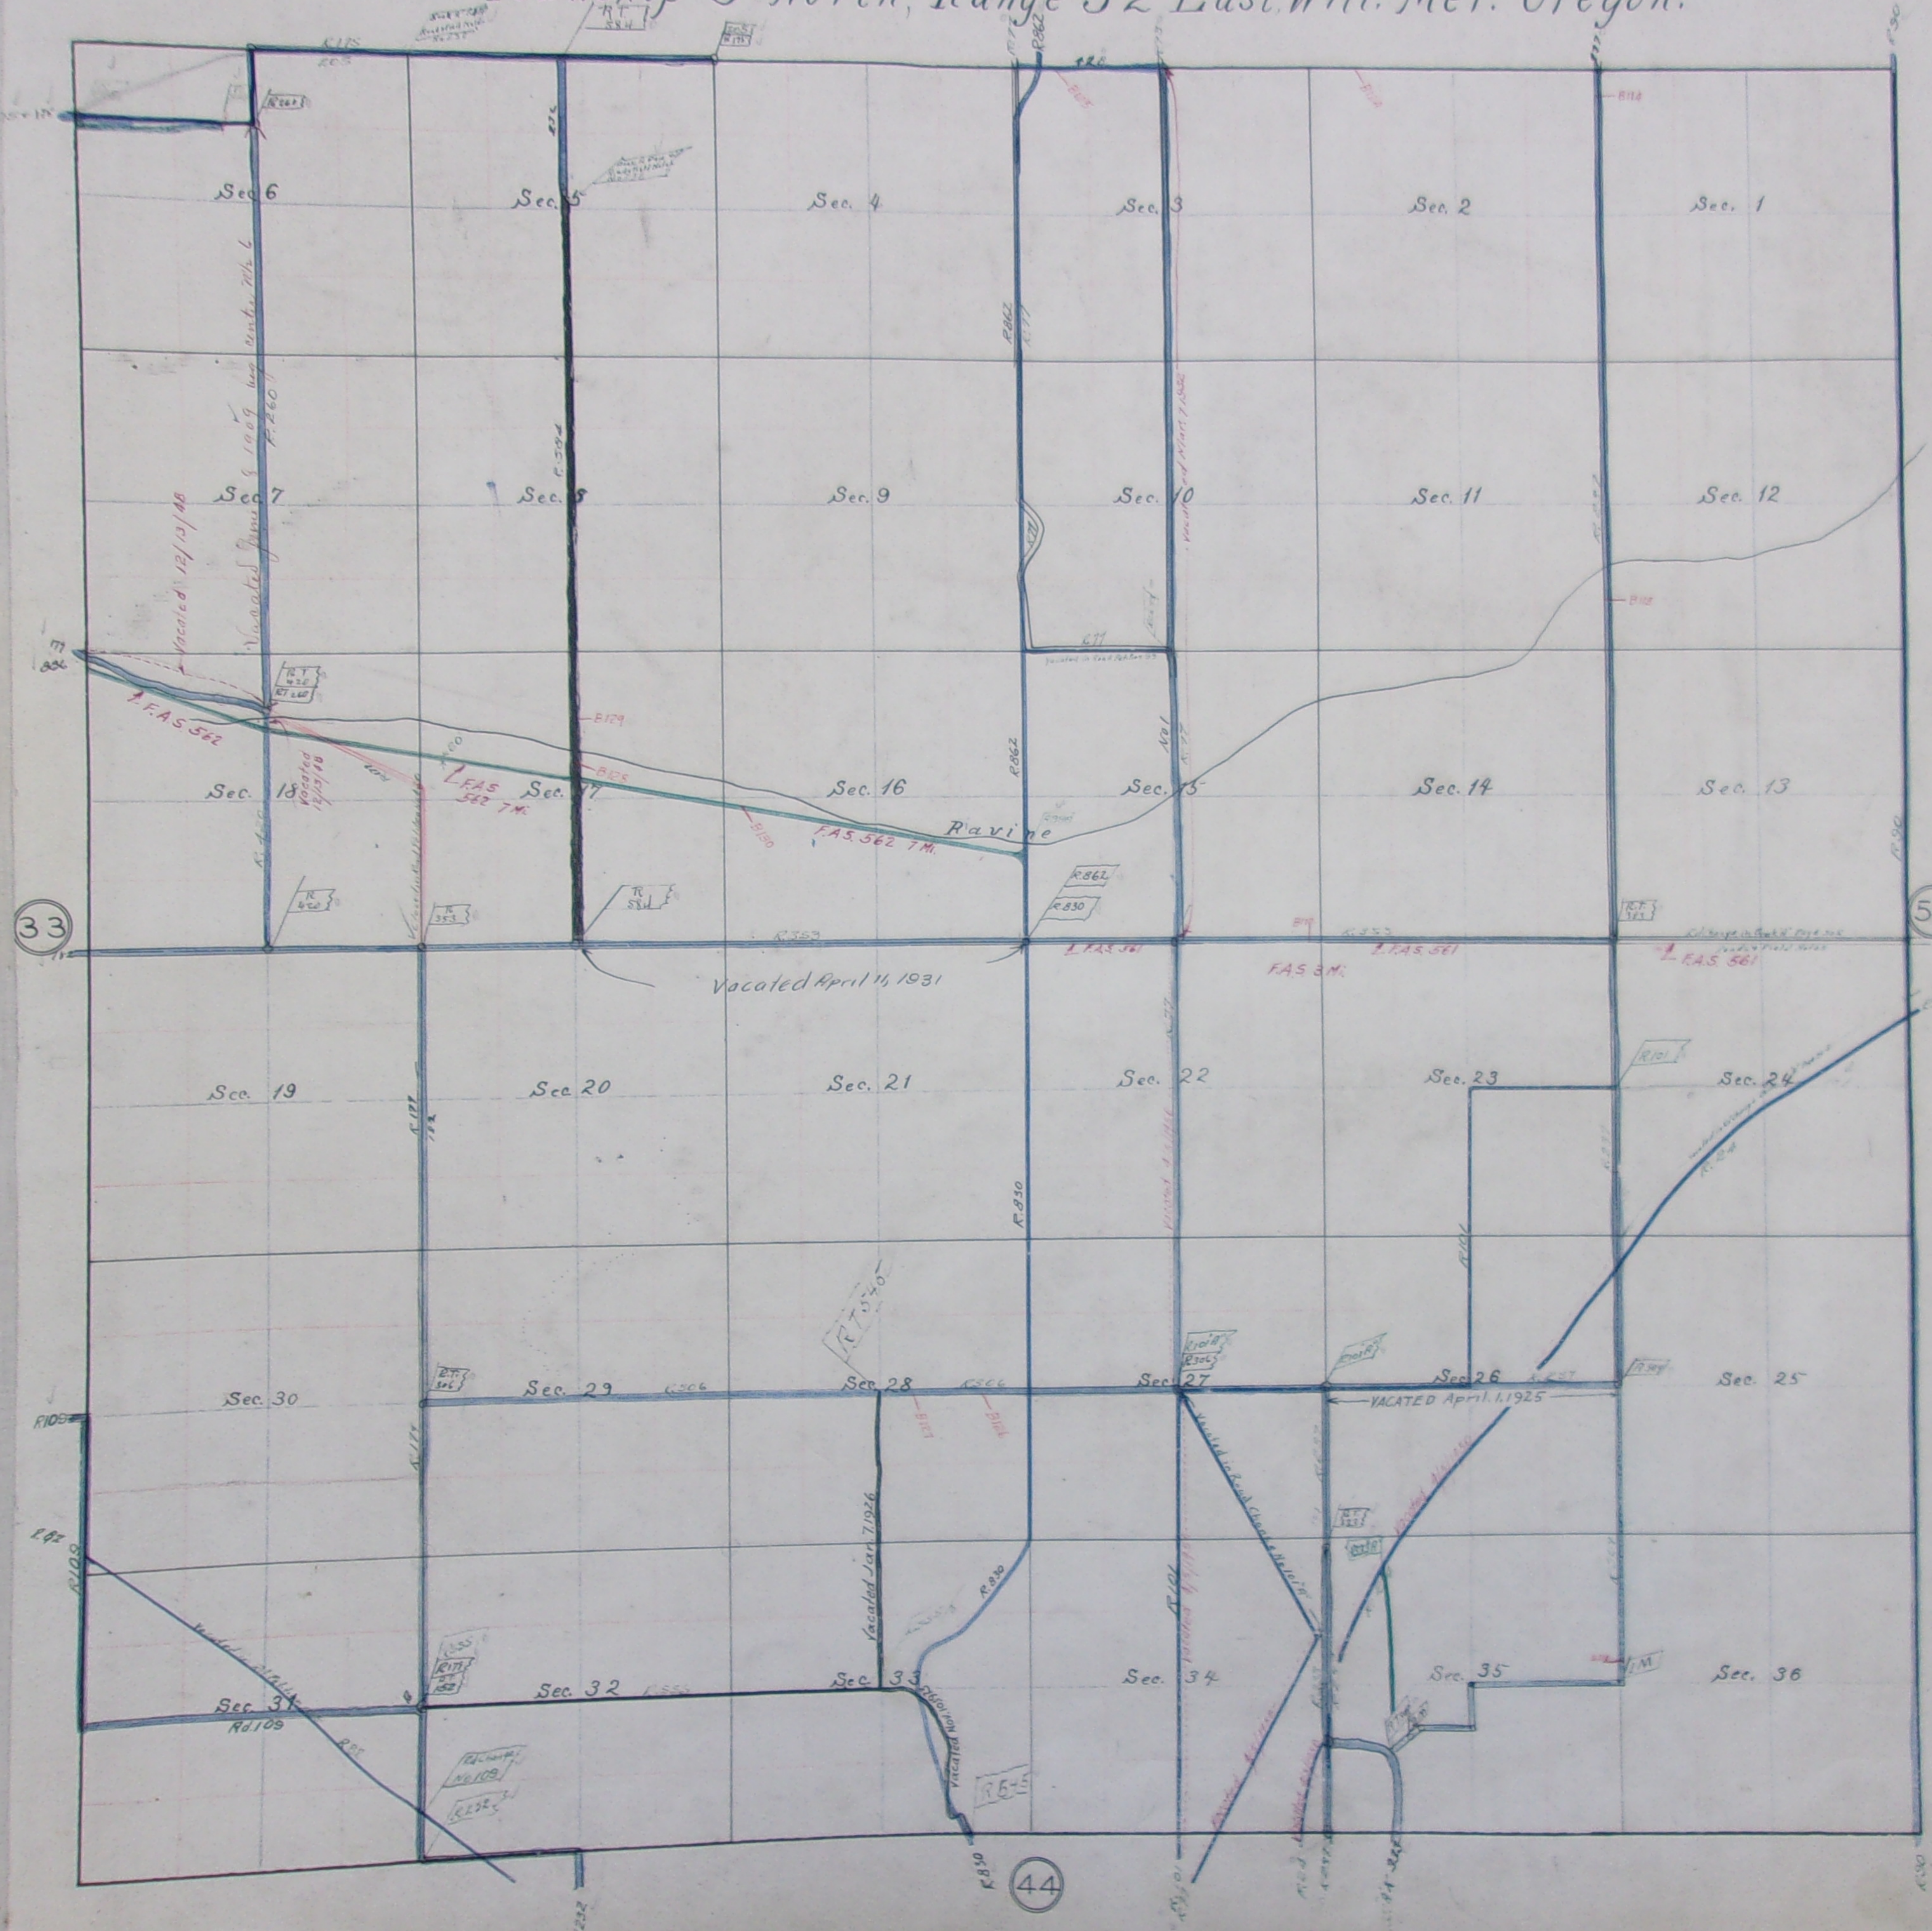

| Date          | No. Box | Book | Page | Date | No. Box | Book | Page |
|---------------|---------|------|------|------|---------|------|------|
| Nov 11 1873   | 420     | 132  |      |      |         |      |      |
| July 11 1891  | 353     | 130  | 9    | 313  |         |      |      |
| May 10 1890   | 333     | 128  | 14   | 544  |         |      |      |
| Apr 11 1888   | 306     |      | 11   | 13   |         |      |      |
| Apr 13 1886   | 260     | 15   | 5    | 231  |         |      |      |
| July 10 1885  | 237     |      | 9    | 75   |         |      |      |
| Apr 10 1884   | 179     | 15   | F    | 318  |         |      |      |
| Apr 10 1884   | 132     | 15   | F    | 317  |         |      |      |
| July 31 1884  | 170     | 16   | F    | 448  |         |      |      |
| Jan 24 1881   | 105     | 13   | E    | 247  |         |      |      |
| May 1884      | 235     |      | F    | 430  |         |      |      |
| Sept 1879     |         |      | D    | 422  |         |      |      |
| July 1873     |         |      |      | 262  |         |      |      |
| May 7 1874    | 574     | 925  | M    | 14   |         |      |      |
| June 8 1919   |         |      | M    | 372  |         |      |      |
| June 8 1923   | 830     |      | O    | 176  |         |      |      |
| Dec 3 1926    | 862     |      | O    |      |         |      |      |
| Oct 4 1929    | 888     |      |      |      |         |      |      |
| Oct 4 1929    | 886     |      |      |      |         |      |      |
| April 11 1931 |         |      |      |      |         |      |      |
| July 31 1904  | 205     |      |      |      |         |      |      |
| Sept 4 1875   | 77      |      |      |      |         |      |      |
| July 1 1880   | 90      |      |      |      |         |      |      |
| July 18 1880  | 58      |      |      |      |         |      |      |
| April 12 1881 | 101     |      |      |      |         |      |      |
| July 18 1872  | 24      |      |      |      |         |      |      |
| Sept 1880     | 80      |      |      |      |         |      |      |
| July 11 1879  | 330     |      |      |      |         |      |      |
| Sept 16 1883  | 118     |      |      |      |         |      |      |

33

57

44

True Meridian  
 1/4 in from N 1/2 Sec 26

Scale 25 chains to 1 inch.