


Township 4 North Range 37 East Will. Mer. Oregon

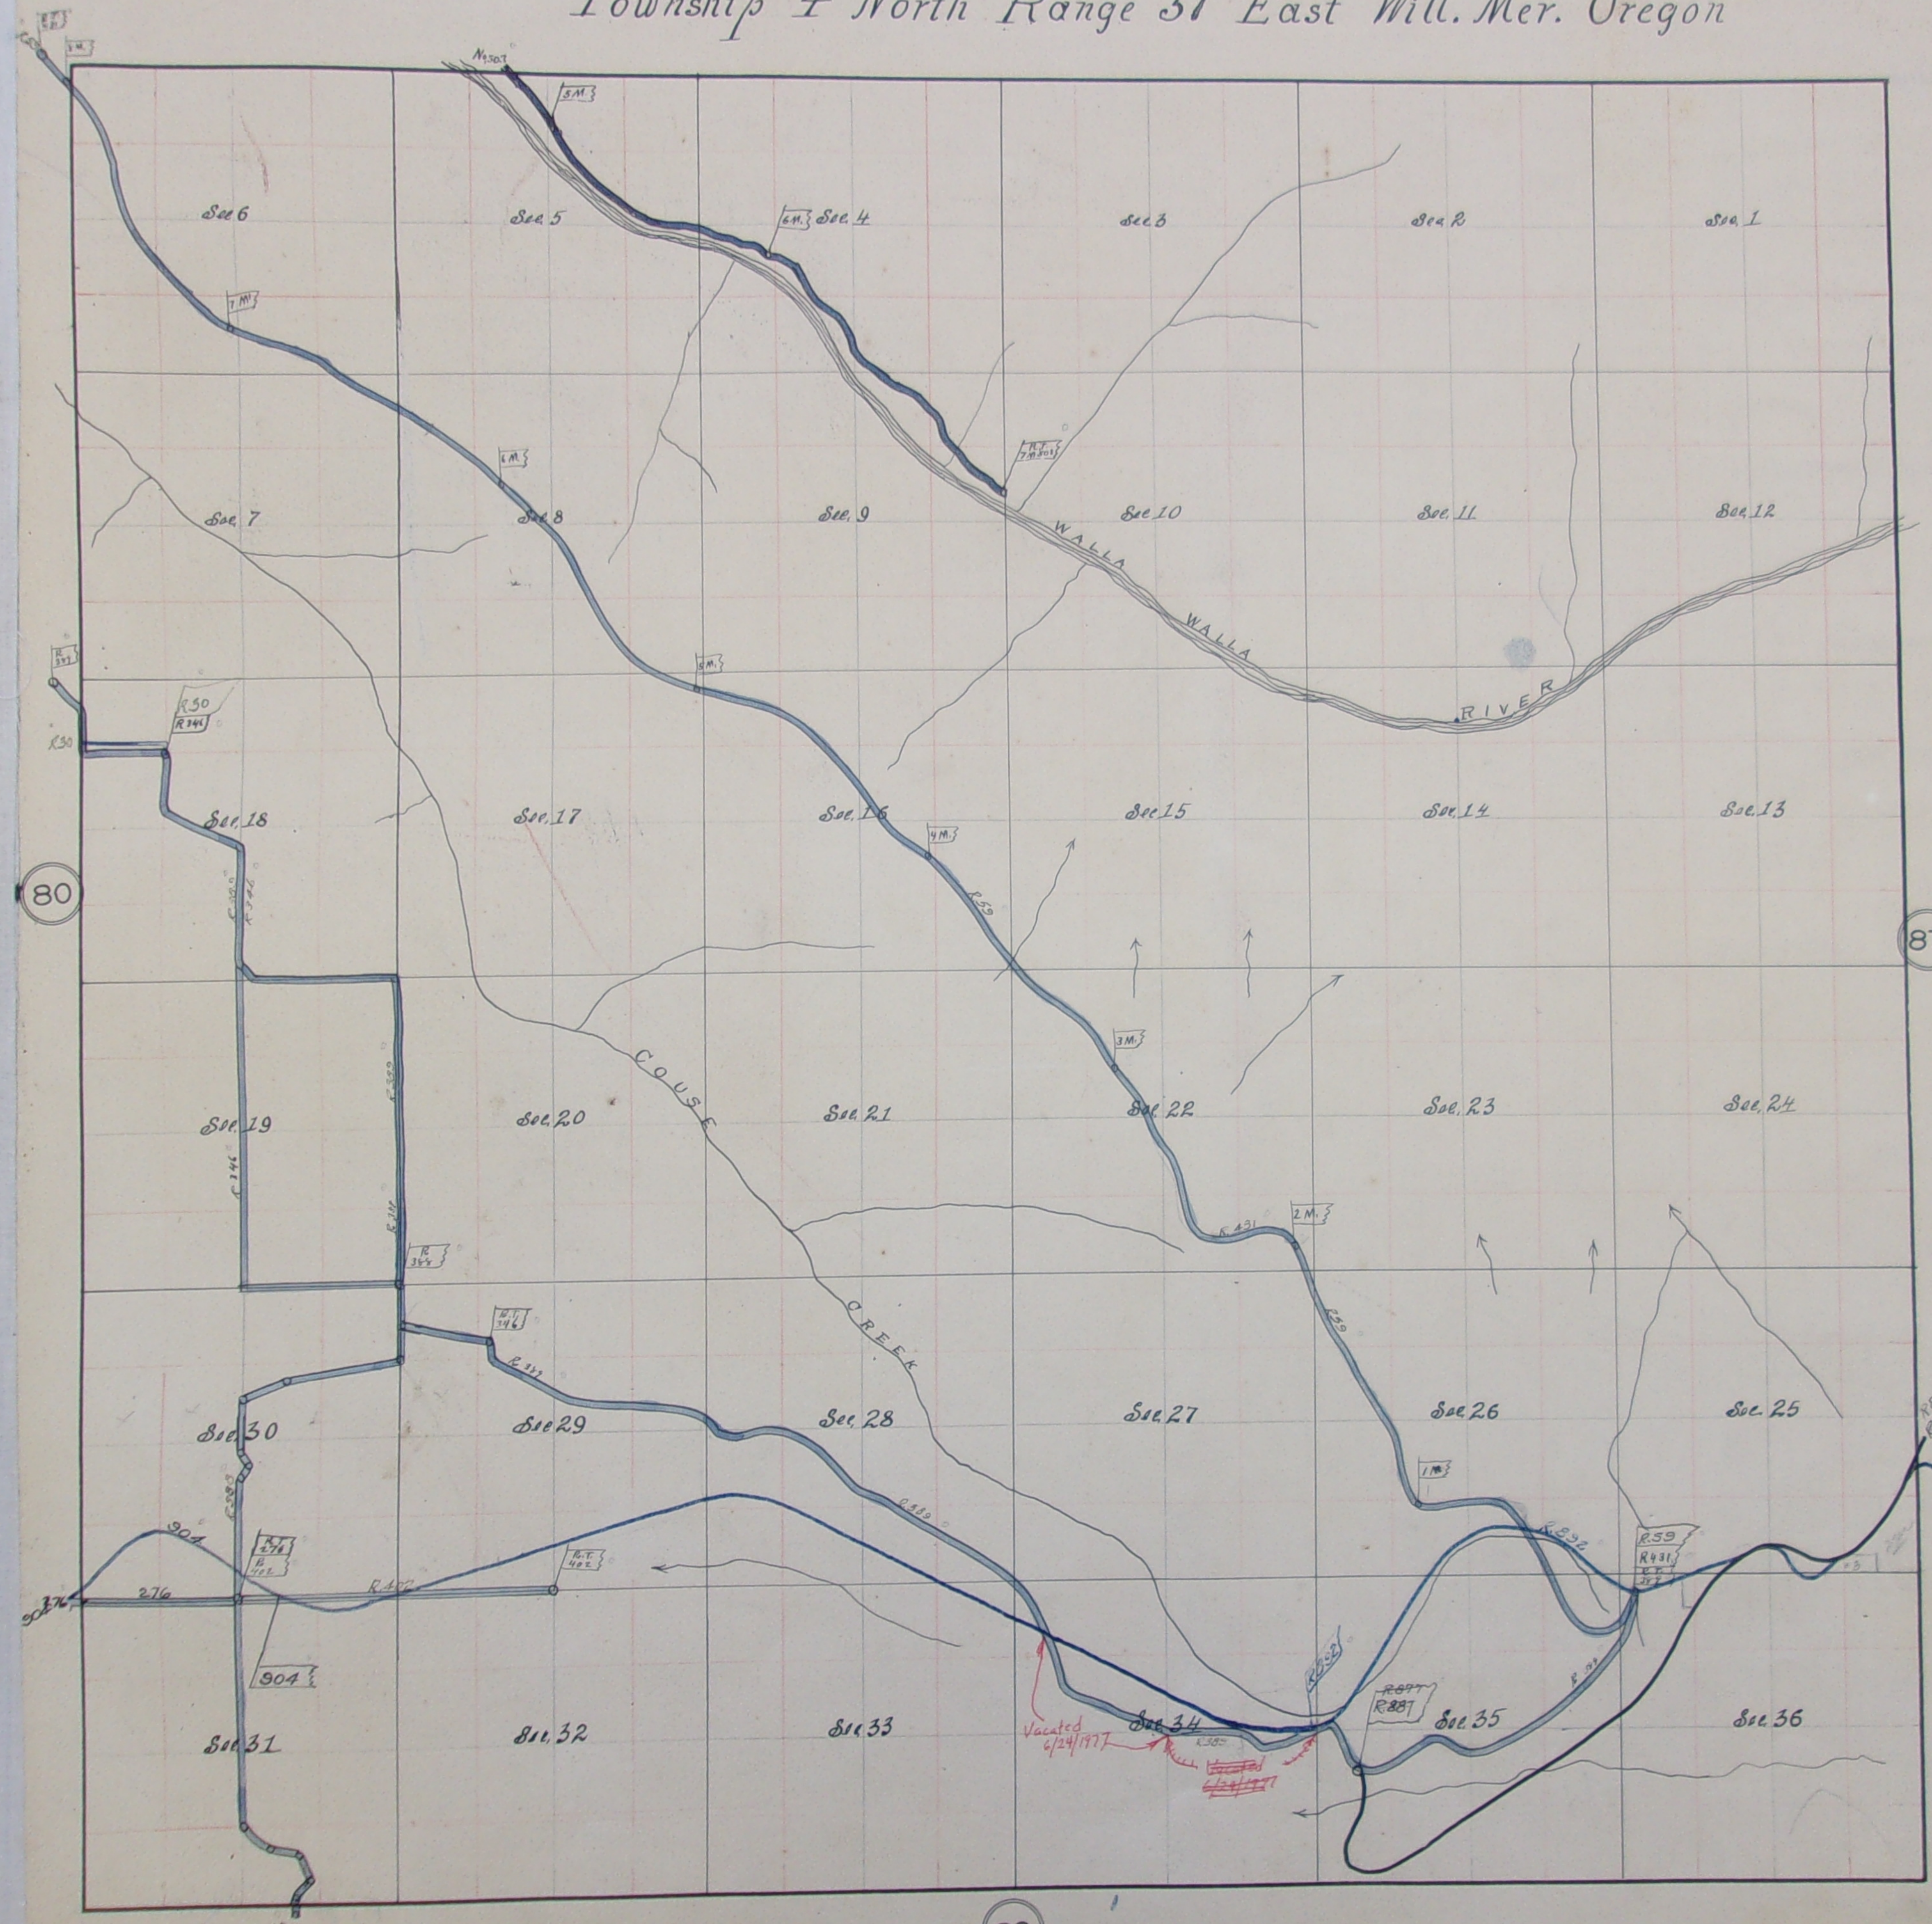

Date	No.	Box	Book	Page	Date	No.	Box	Book	Page
Nov. 9 1893	431	131	J	604					
July 13 1892	388	130	J	220					
Apr 5 1892	349	128	J	308					
Nov 9 1892	402	130	J	349					
Apr 5 1890	346	129	H	575					
Jan 15 1887	276	15	G	471					
Nov 10 1897	503								
Oct 5 1925	877								
Jan. 1893	50								
Apr. 4 1890	33								
Oct 4, 1892	552								
Vacated									
6/24/1977	307								

True Meridian
 100 feet from 1st E. 22. E.

Scale 25 chains to 1 inch