
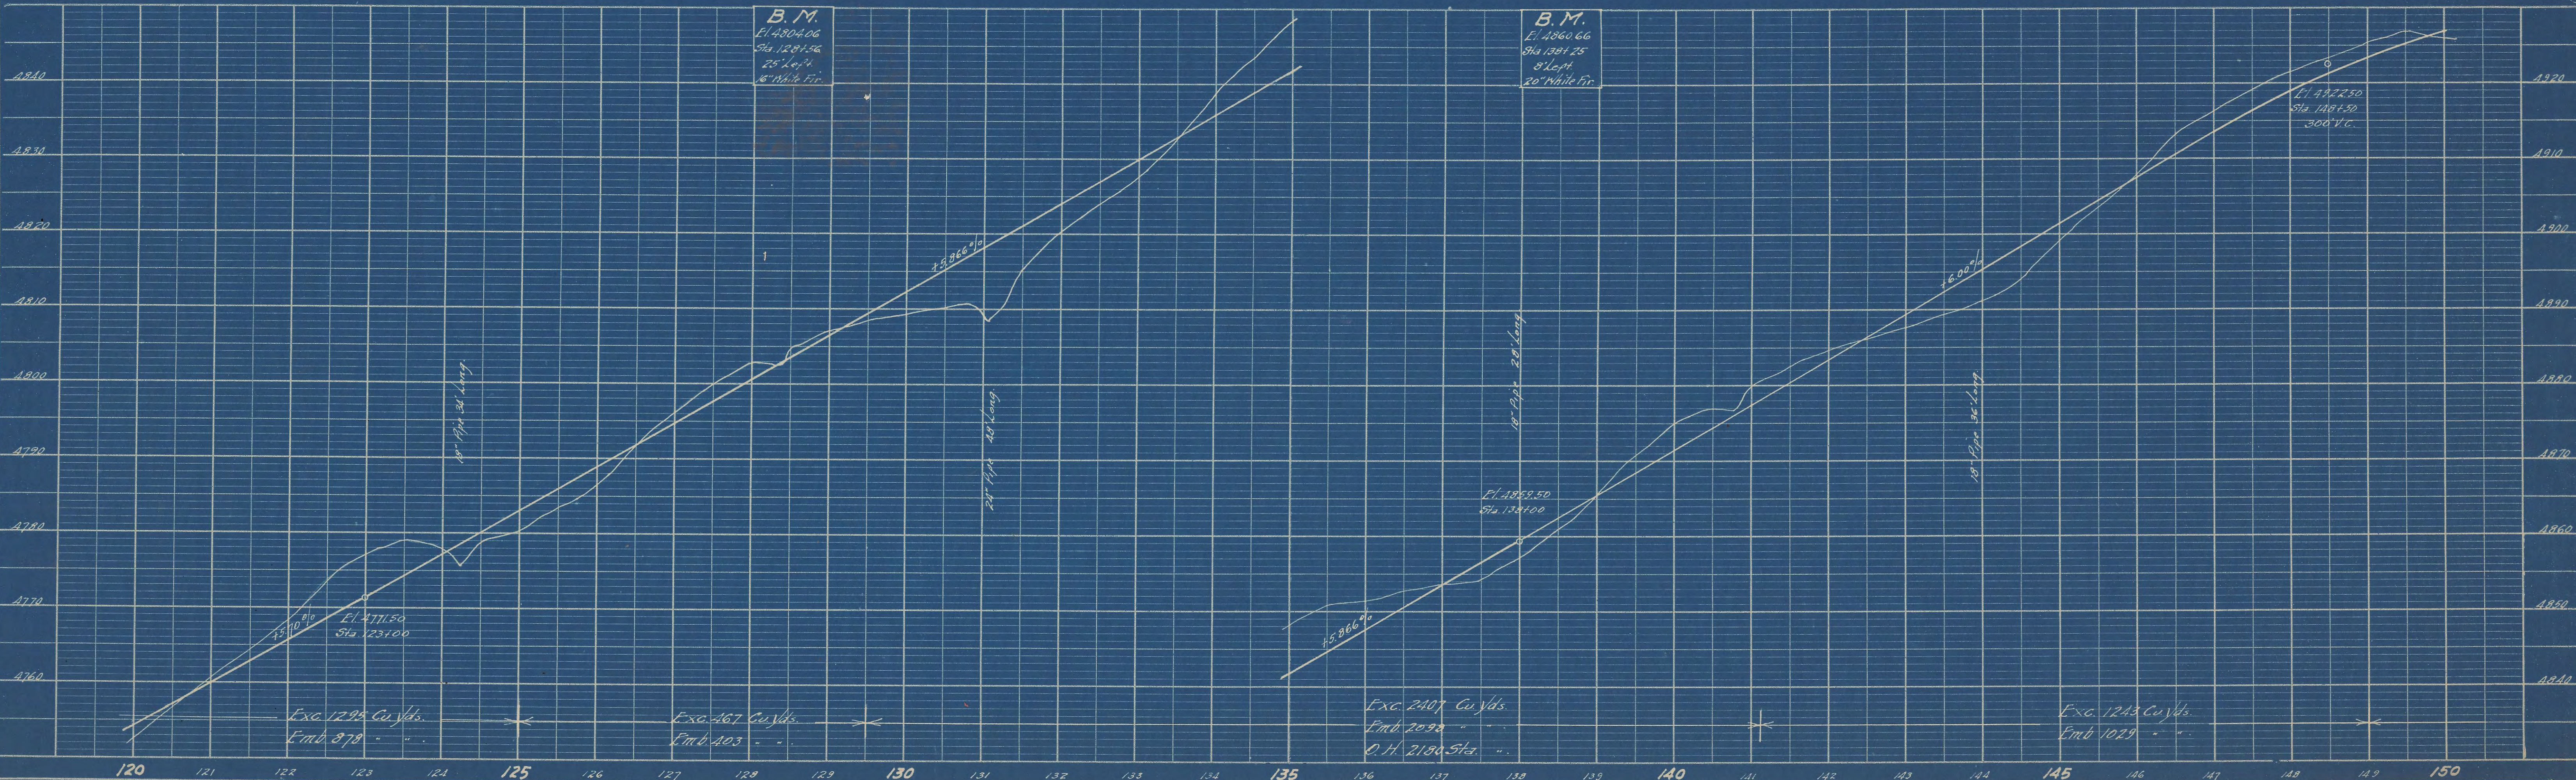


PLAN	SURVEYED	DATE
NO.	BY	

PROFILE	SURVEYED	DATE
NO.	BY	

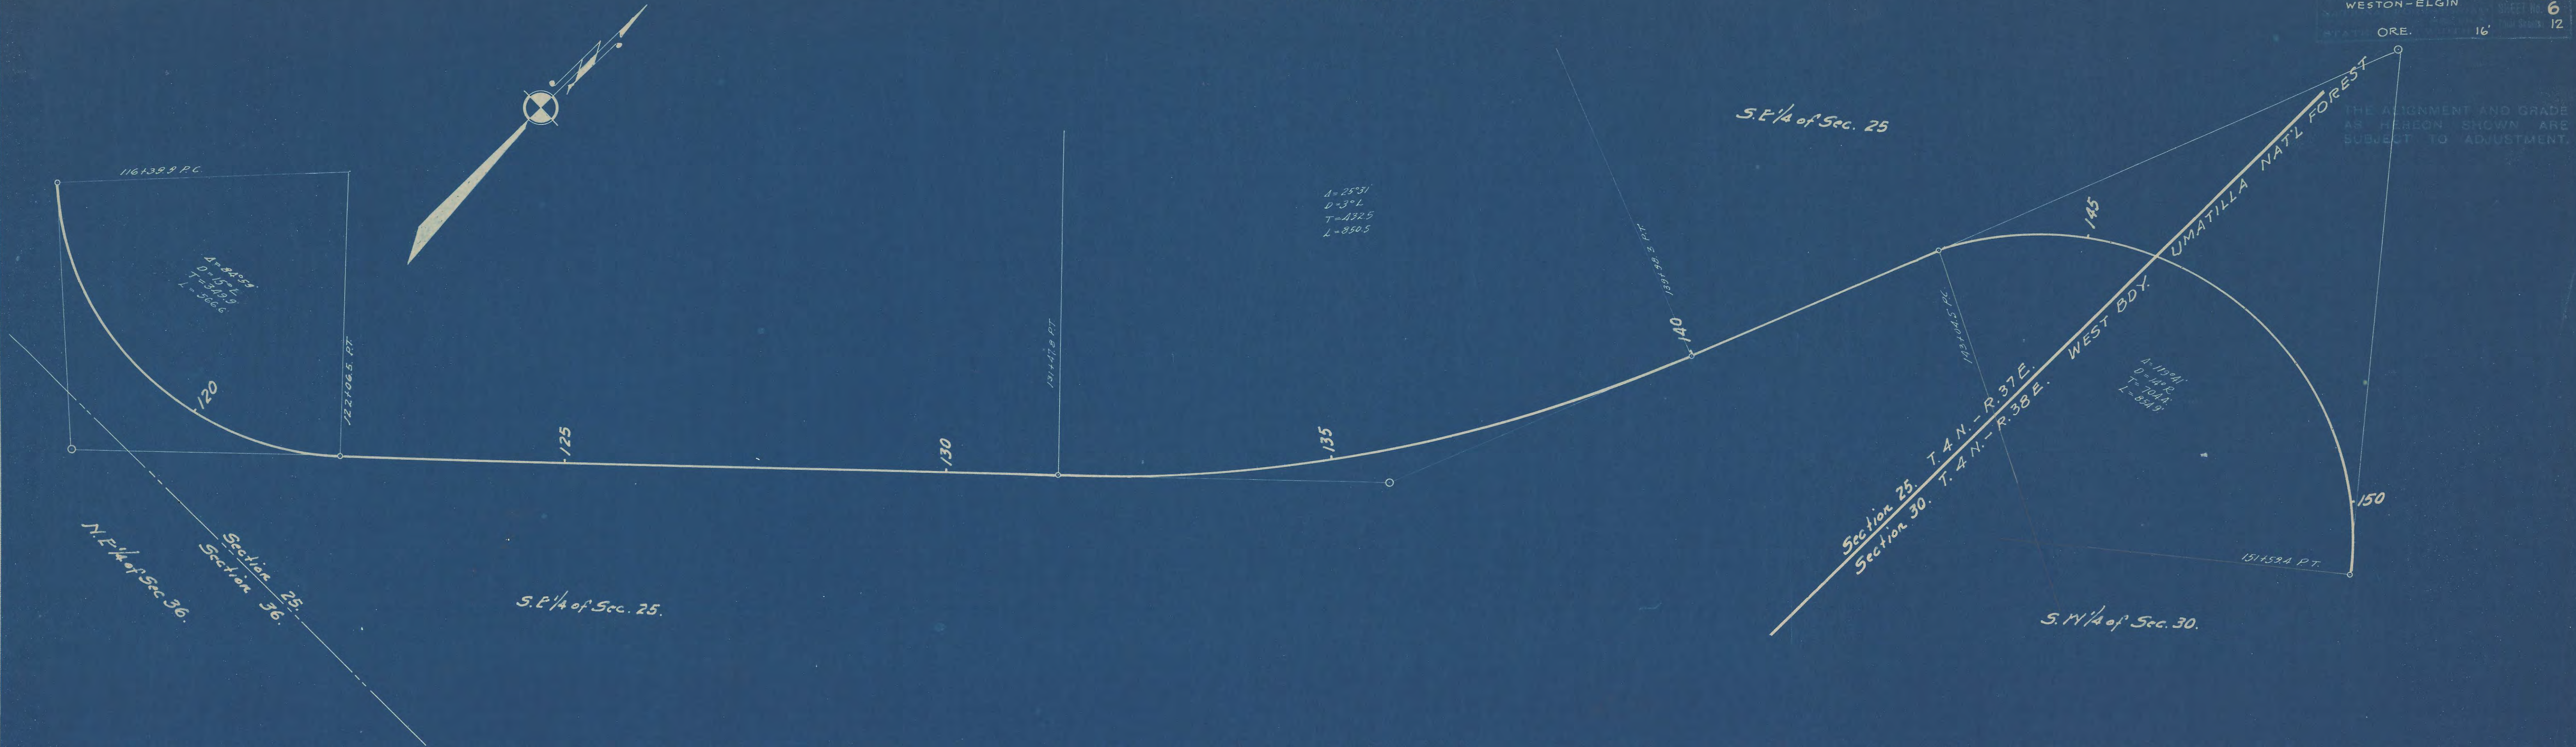

T4 N- R38 E. W.M.

WESTON-ELGIN
ORE 16' 37A
7
12







S. E 1/4 of Sec. 25.

DATE	1/22/22
BY	E. J. ...
PROJECT	...
PLANNED	...
ALIGNED	...
NOTE BOOK	...
NO.	...



DATE	1/22/22
BY	E. J. ...
PROJECT	...
PLANNED	...
ALIGNED	...
NOTE BOOK	...
NO.	...

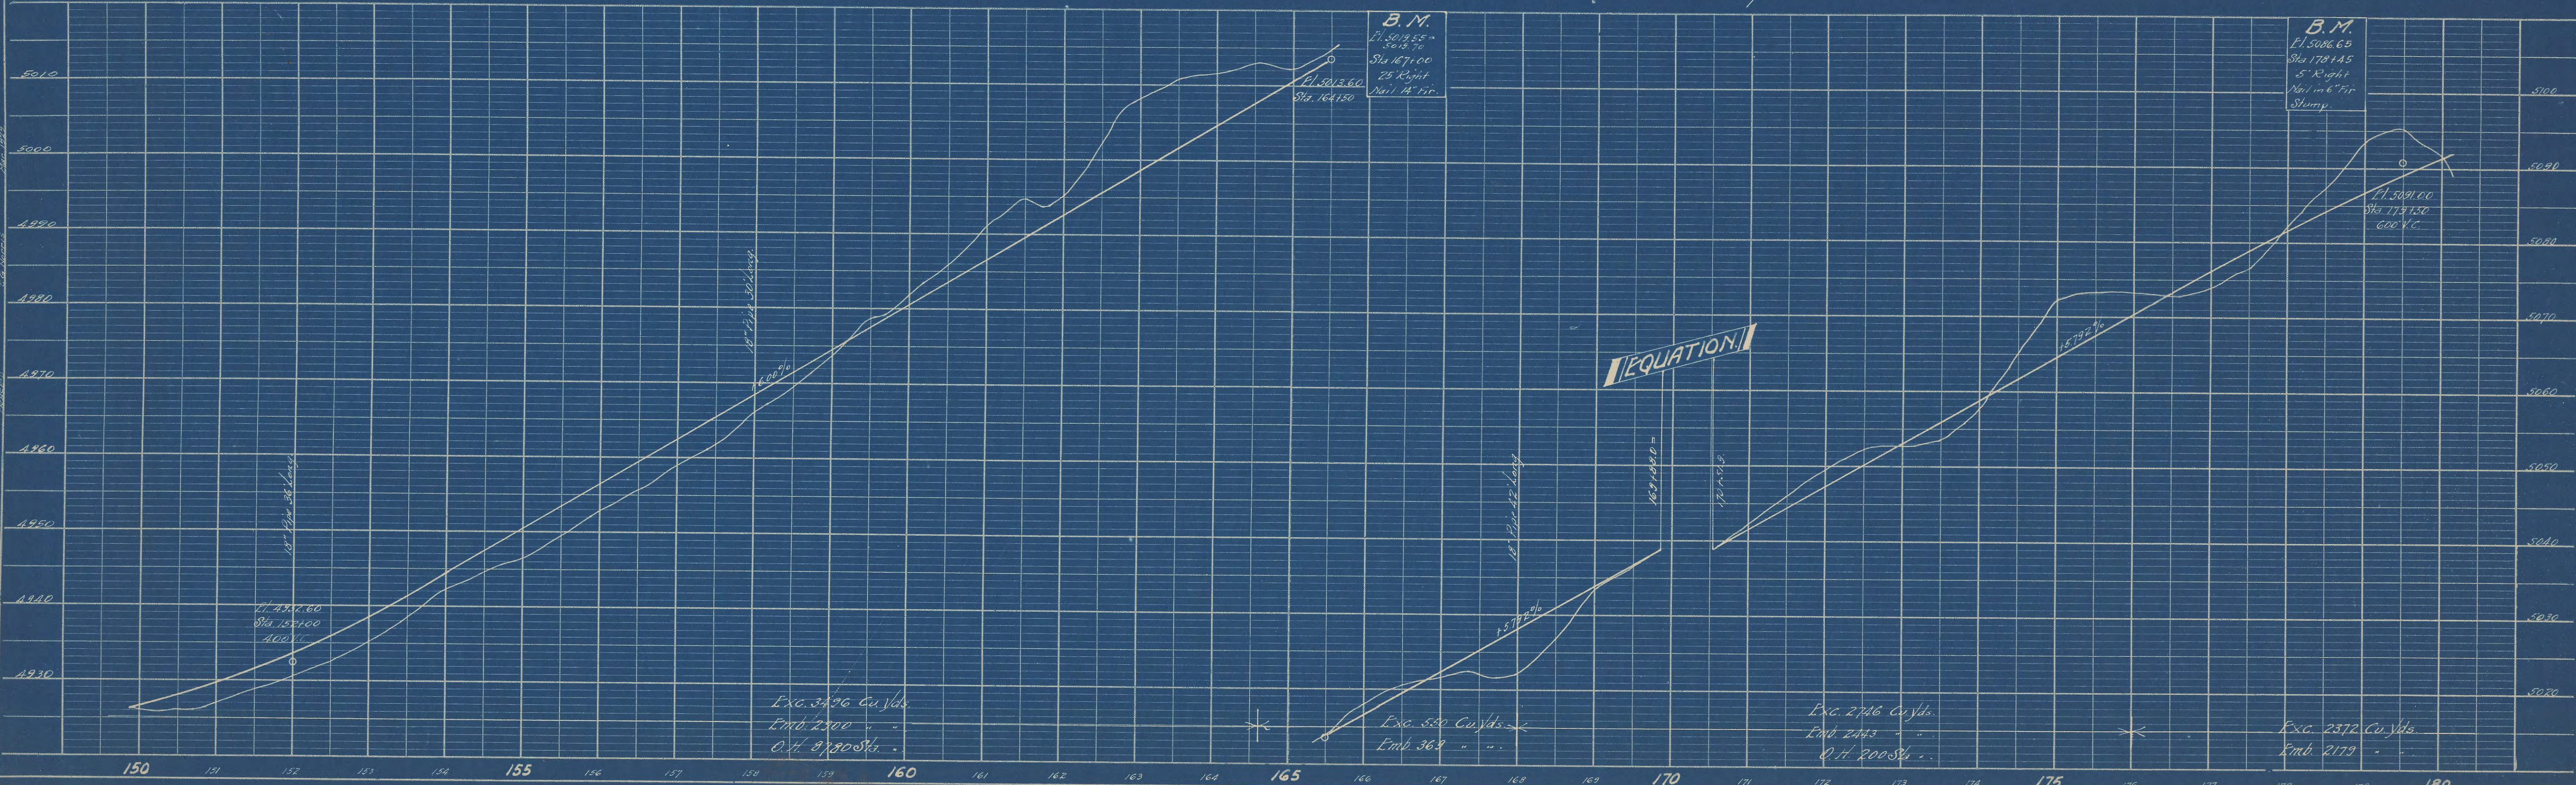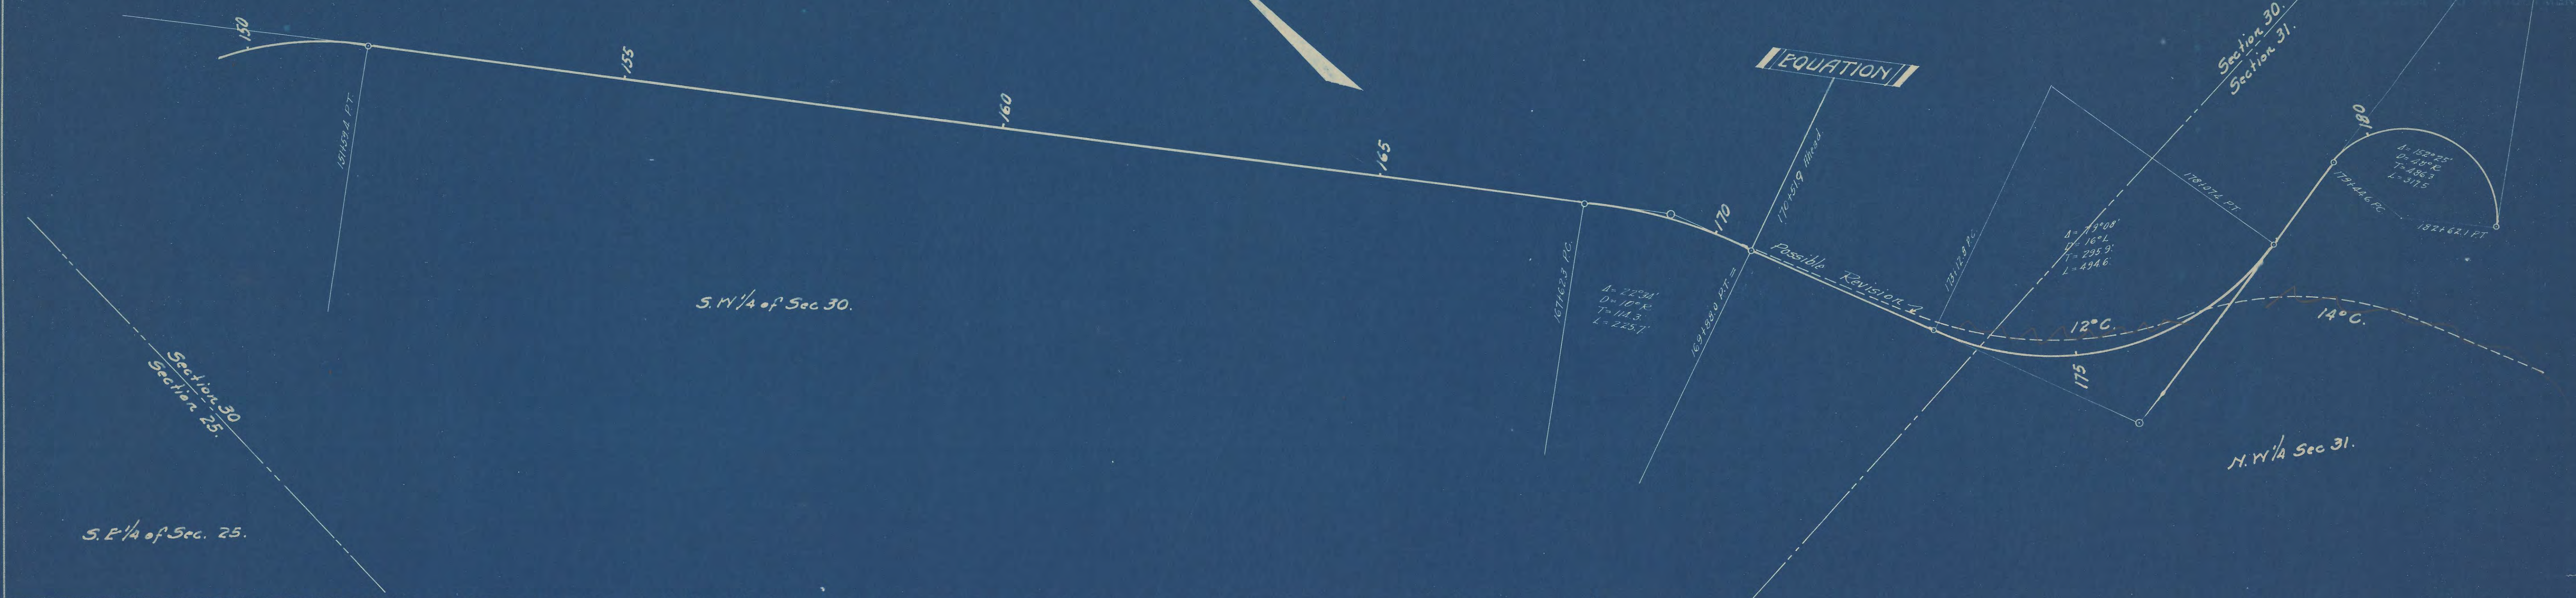

THE ALIGNMENT AND GRADE AS HEREON SHOWN ARE SUBJECT TO ADJUSTMENT.

DATE	1922
BY	J. E. M.
PROJECT	WESTON-ELGIN
NOTE BOOK	16'
NO.	37A


DATE	1922
BY	J. E. M.
PROJECT	WESTON-ELGIN
NOTE BOOK	16'
NO.	37A

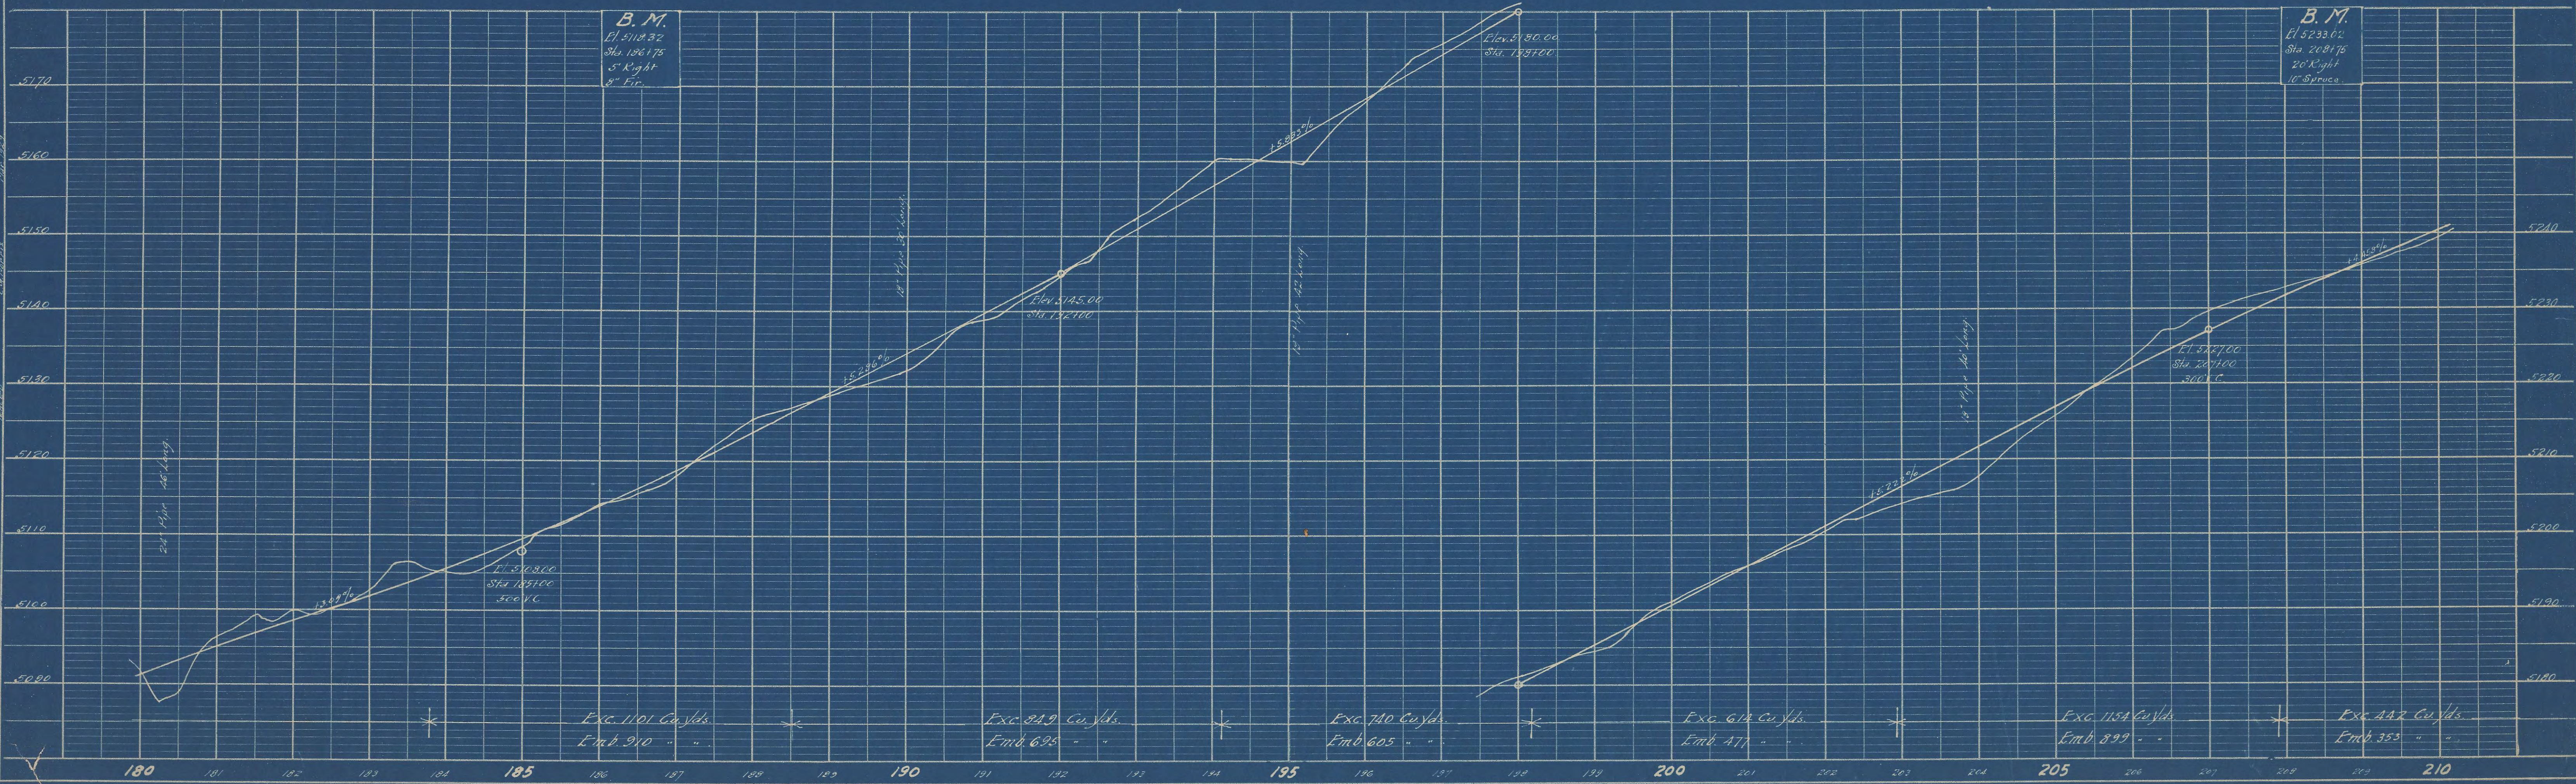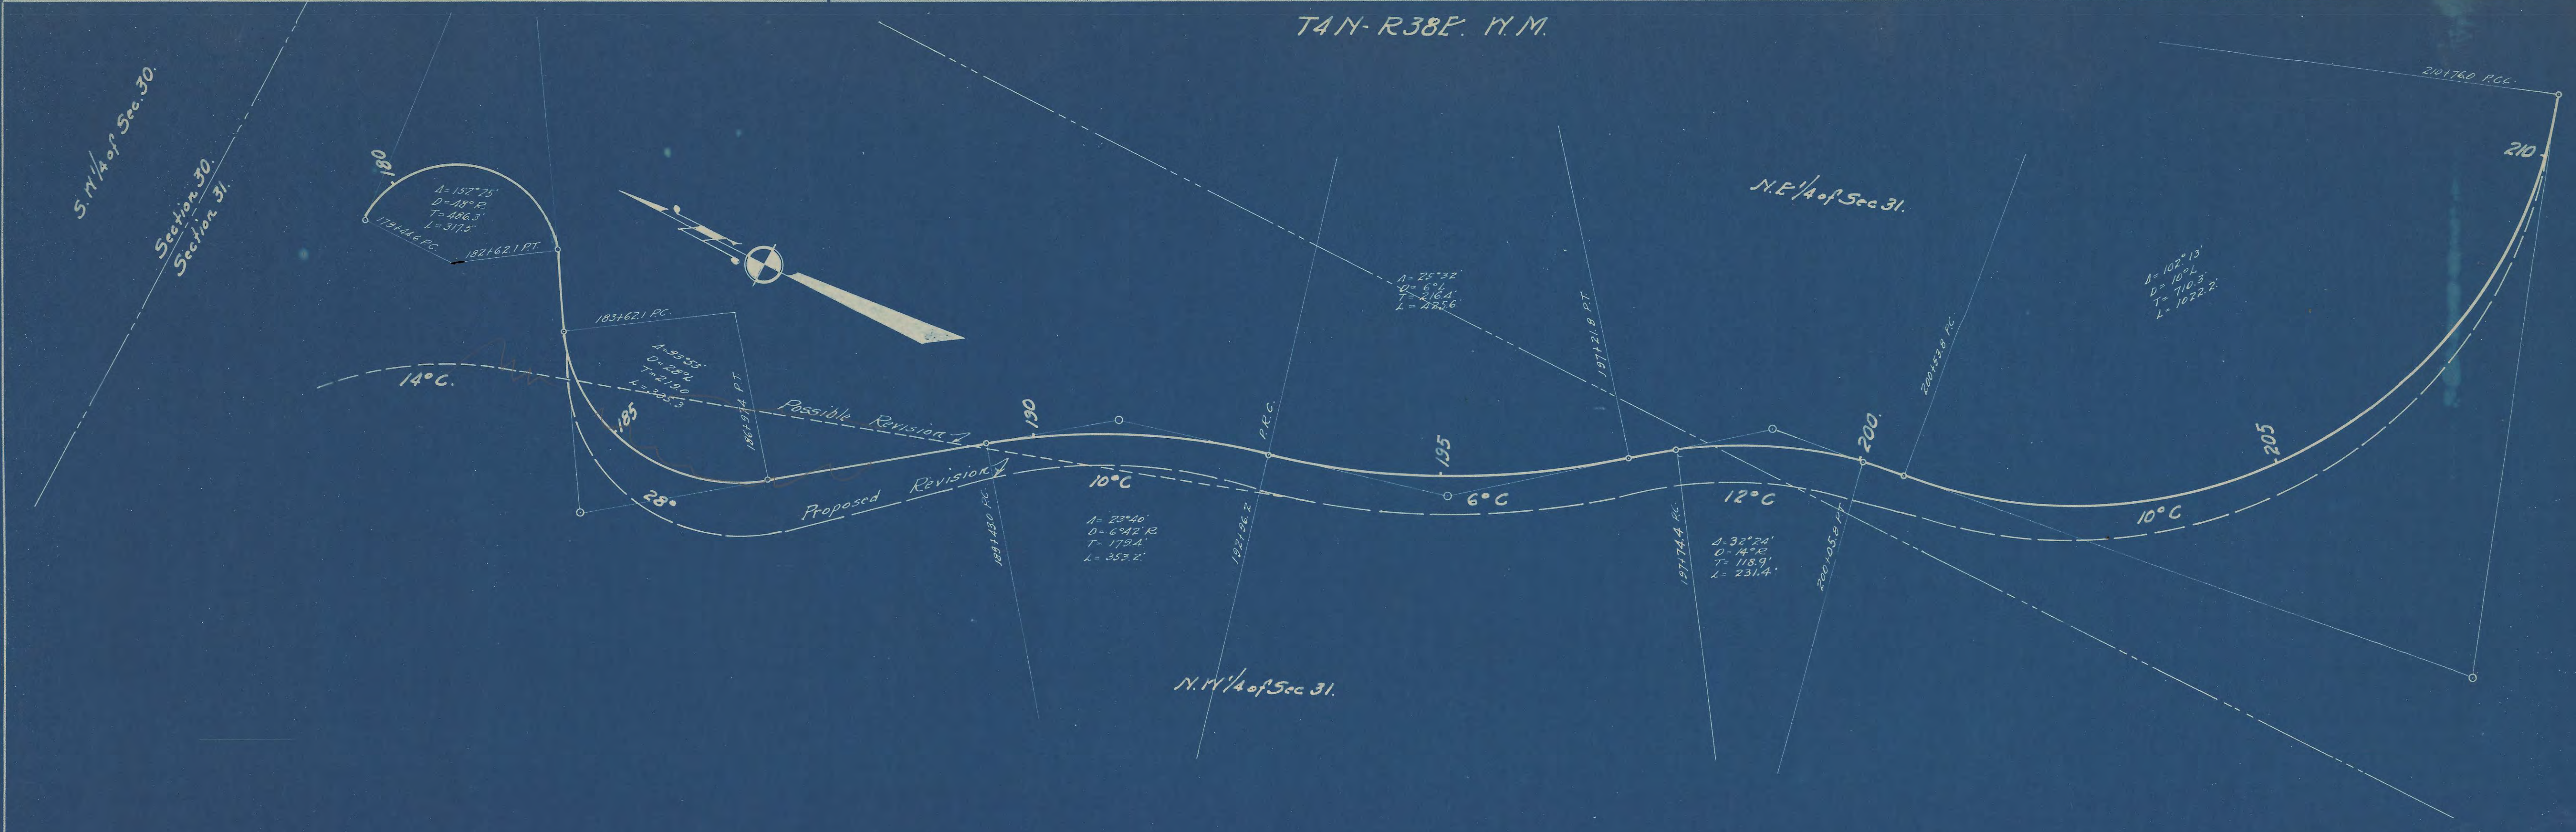

T4N-R38E-11M

WESTON-ELGIN
ORE 16' 12

PLAN	DATE	BY
REVISIONS	1922	
NOTED		
BY		
DATE		
BY		
DATE		

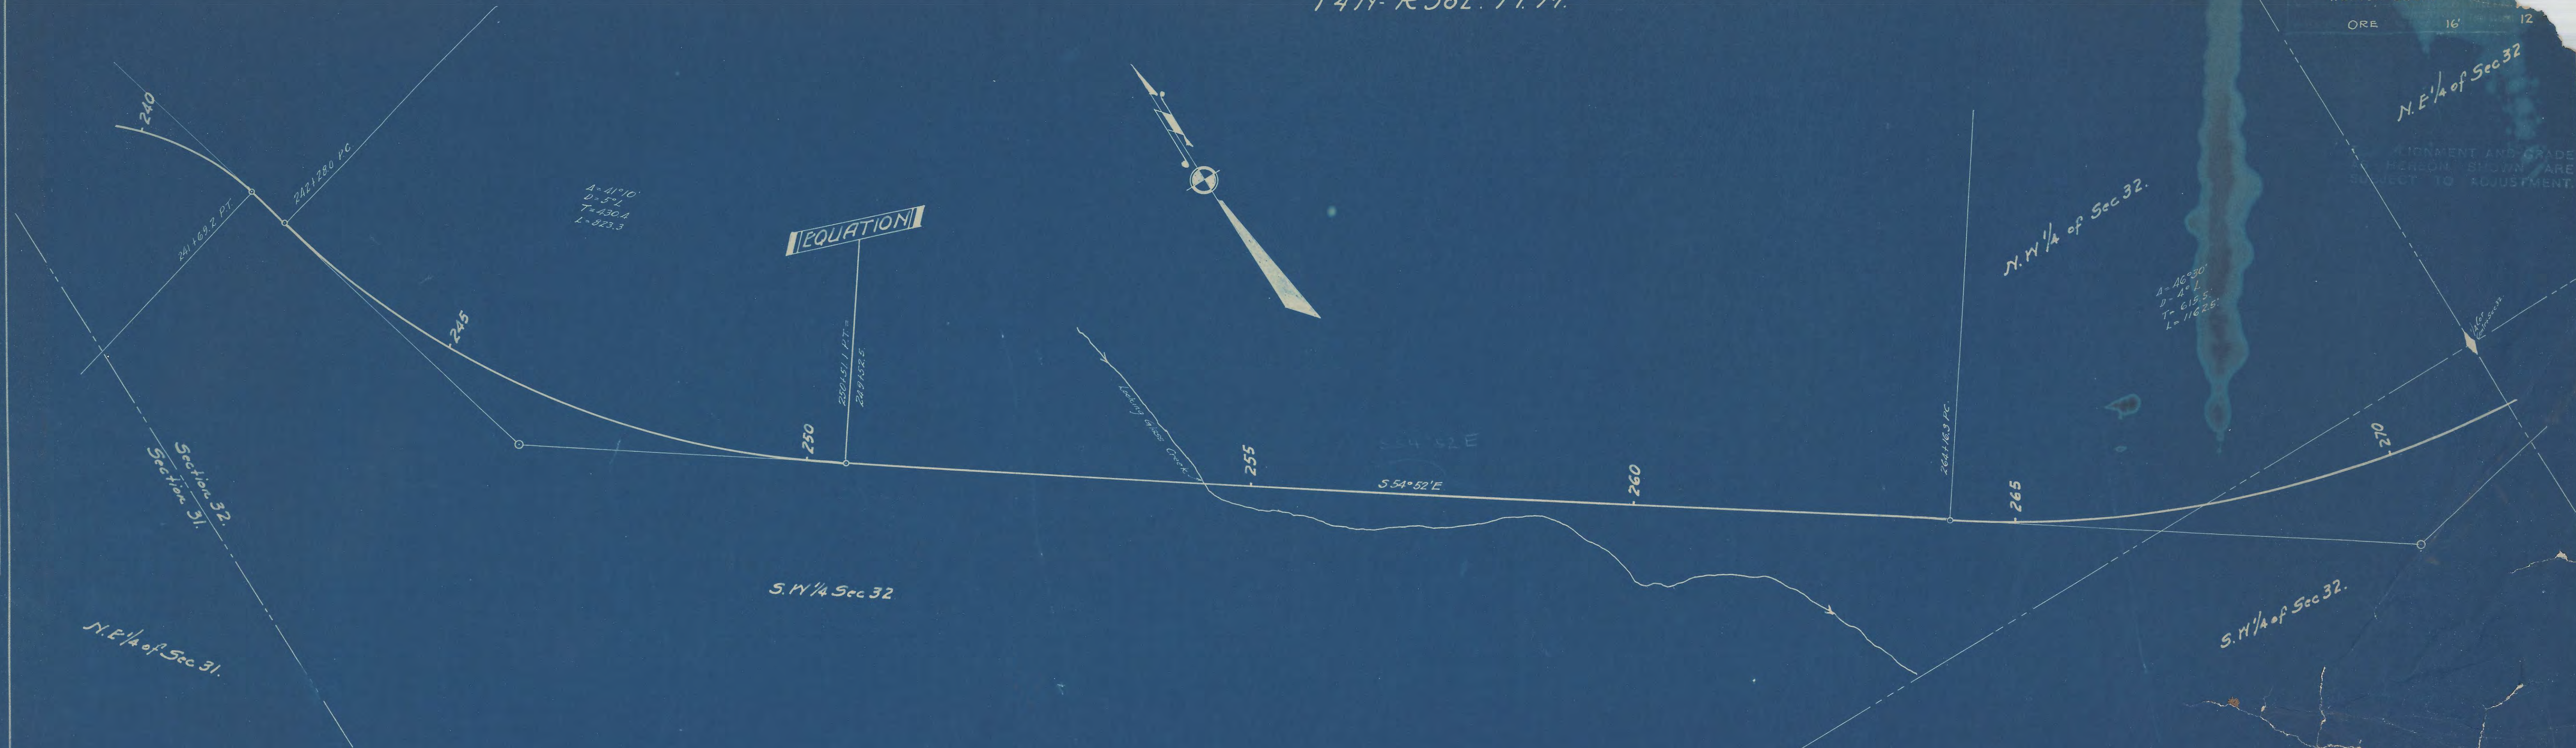

PROFILE	DATE	BY
REVISIONS	1922	
NOTED		
BY		
DATE		
BY		
DATE		

