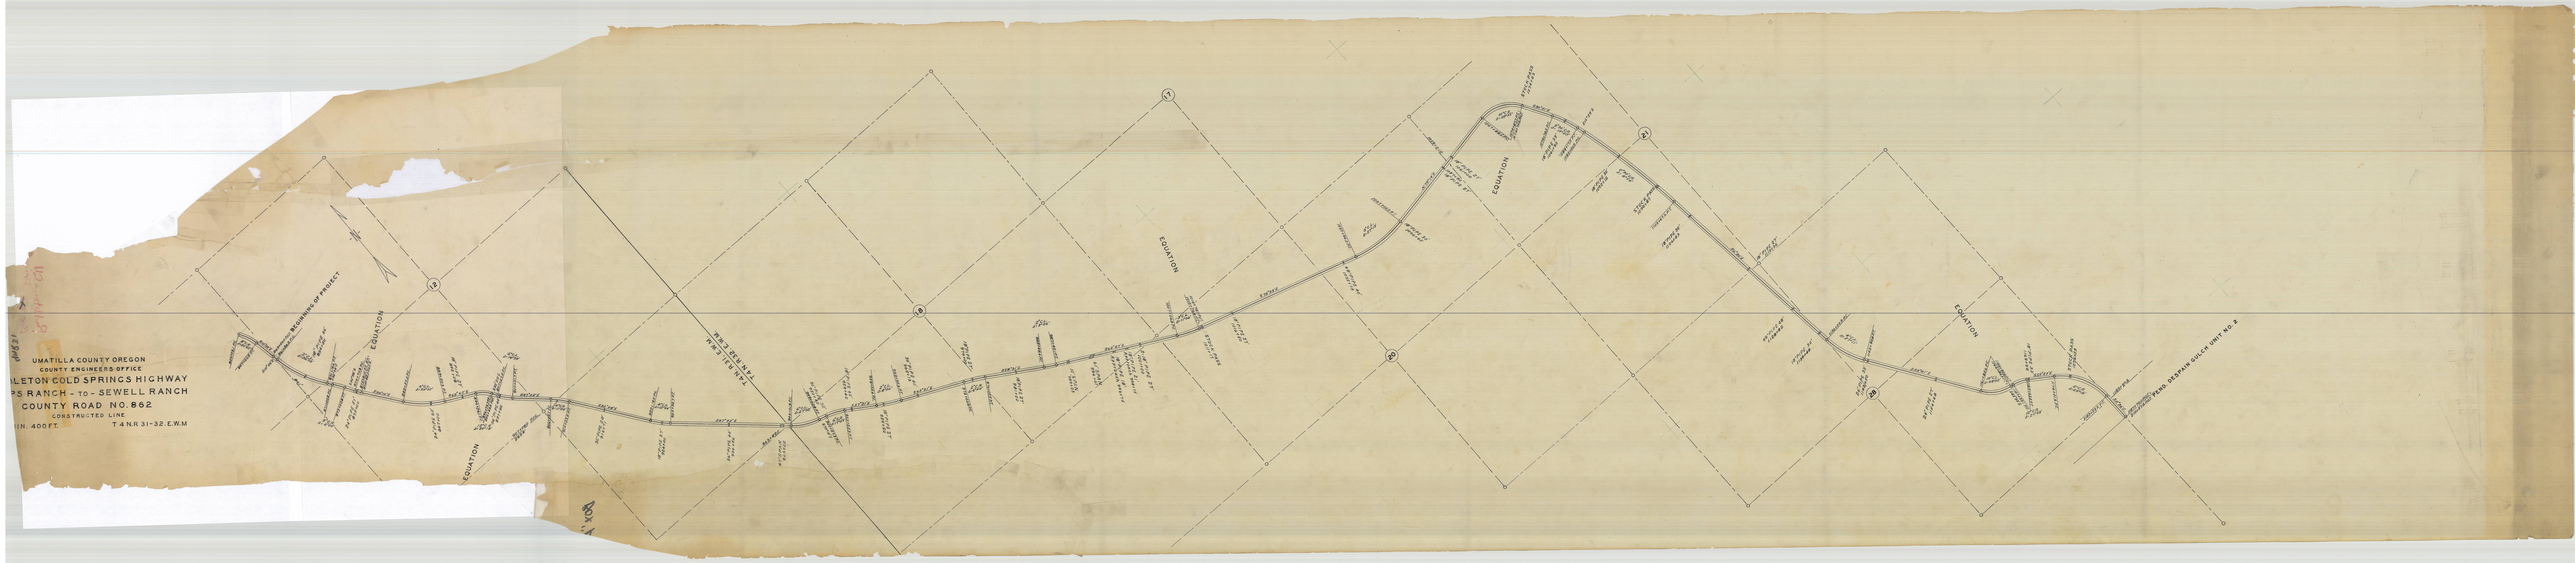
UMATILLA COUNTY OREGON
COUNTY ENGINEERS OFFICE
LETON COLD SPRINGS HIGHWAY
PS RANCH - TO - SEWELL RANCH
COUNTY ROAD NO. 862
CONSTRUCTED LINE
IN. 400FT.
T 4 N R 31-32 E.W.M
BEGINNING OF PROJECT
EQUATION
EQUATION
EQUATION
EQUATION
EQUATION
END OF PROJECT
END DESPAIR GULCH UNIT NO. 2