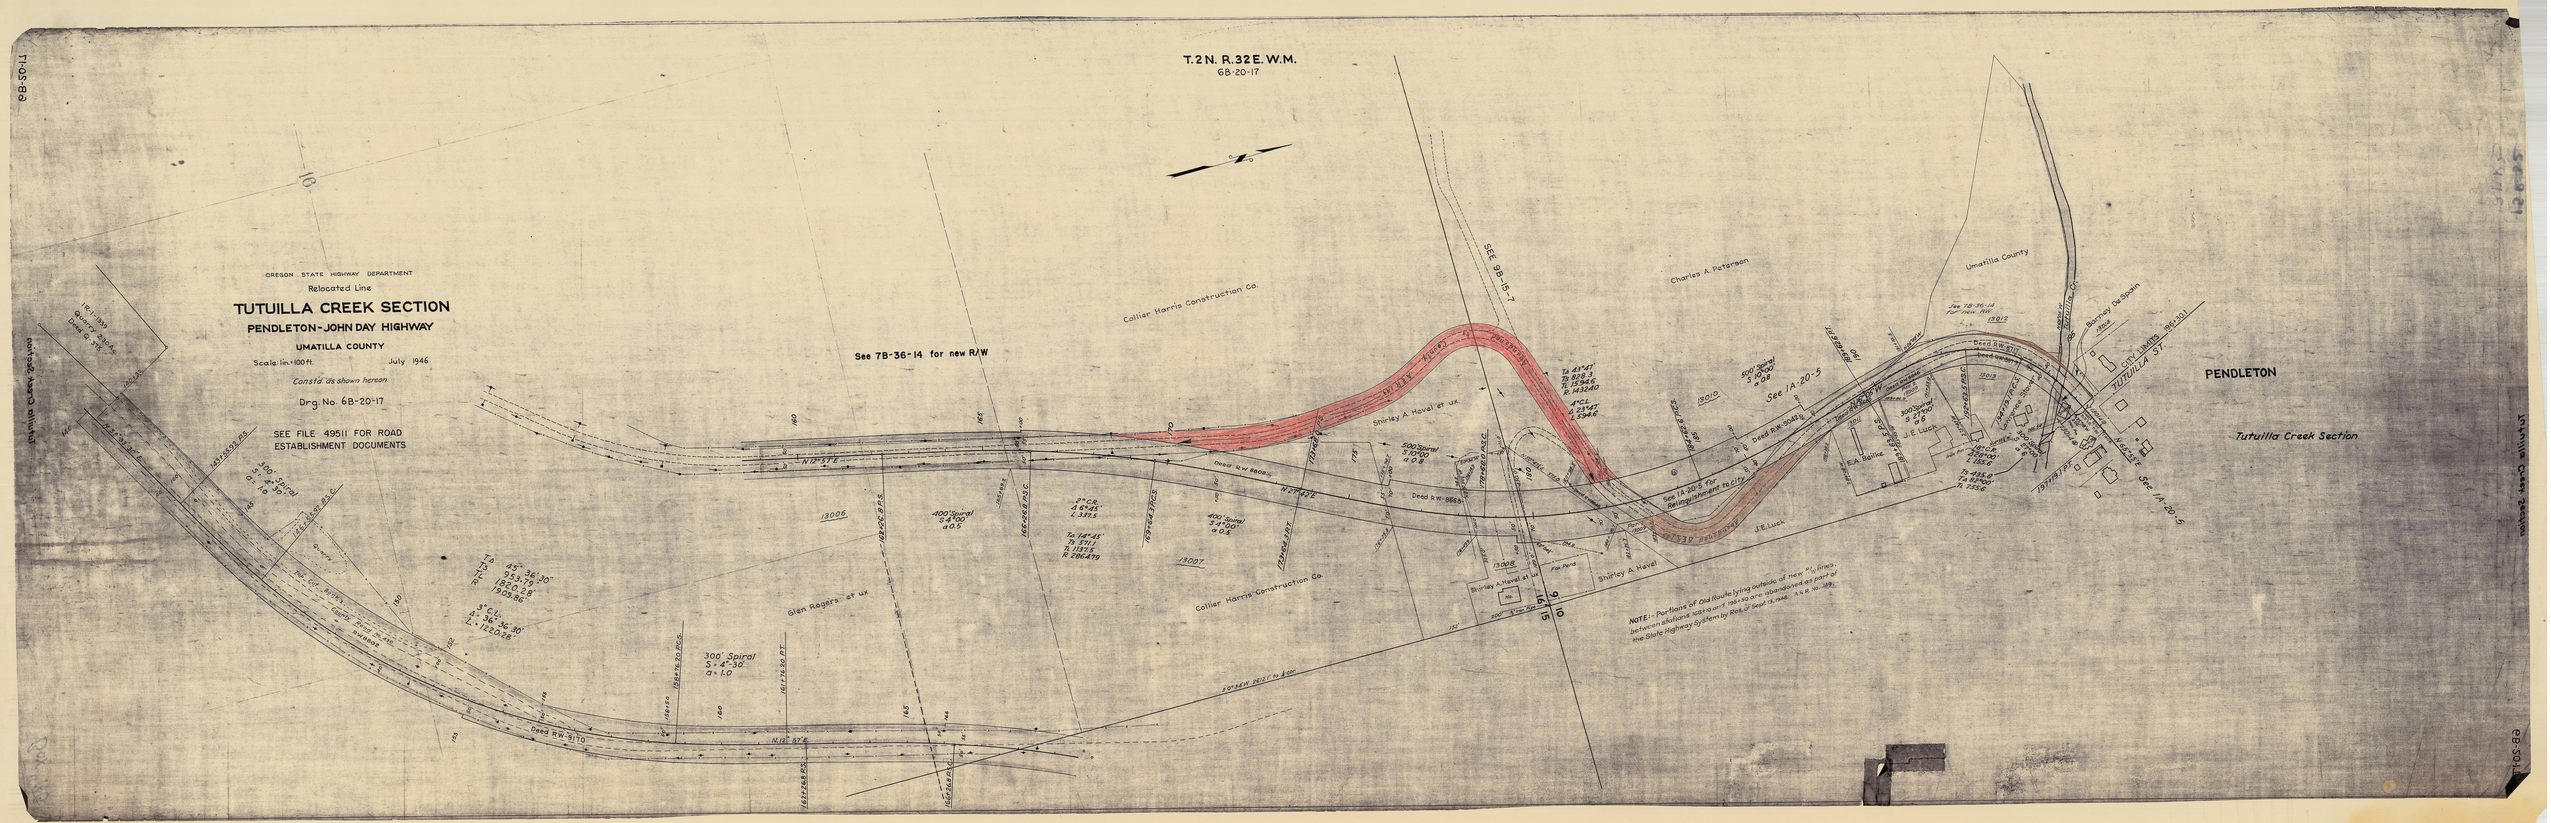
T. 2 N. R. 32 E. W.M.
6B-20-17
OREGON STATE HIGHWAY DEPARTMENT
Relocated Line
TUTUILLA CREEK SECTION
PENDLETON-JOHN DAY HIGHWAY
UMATILLA COUNTY
Scale: 1in.=100ft.
July 1946
Consta ds shown hereon
Drg. No. 6B-20-17
SEE FILE 49511 FOR ROAD ESTABLISHMENT DOCUMENTS
See 7B-36-14 for new R/W
Collier Harris Construction Co.
Charles A. Peterson
Umatilla County
Glen Rogers et ux
Shirley A. Haval et ux
J.E. Luck
E.A. Baillie
Bonney de Spain
PENDLETON
Tutuilla Creek Section
See 1A-20-5
See 1A-20-5 for relinquishment to city
Deed R/W-9170
Deed R/W-9349
Deed R/W-8808
Deed R/W-8889
NOTE:- Portions of Old Route lying outside of new "R" lines between stations 1+00 to 1+85 are abandoned as part of the State Highway System by Res. of Sept. 13, 1948.