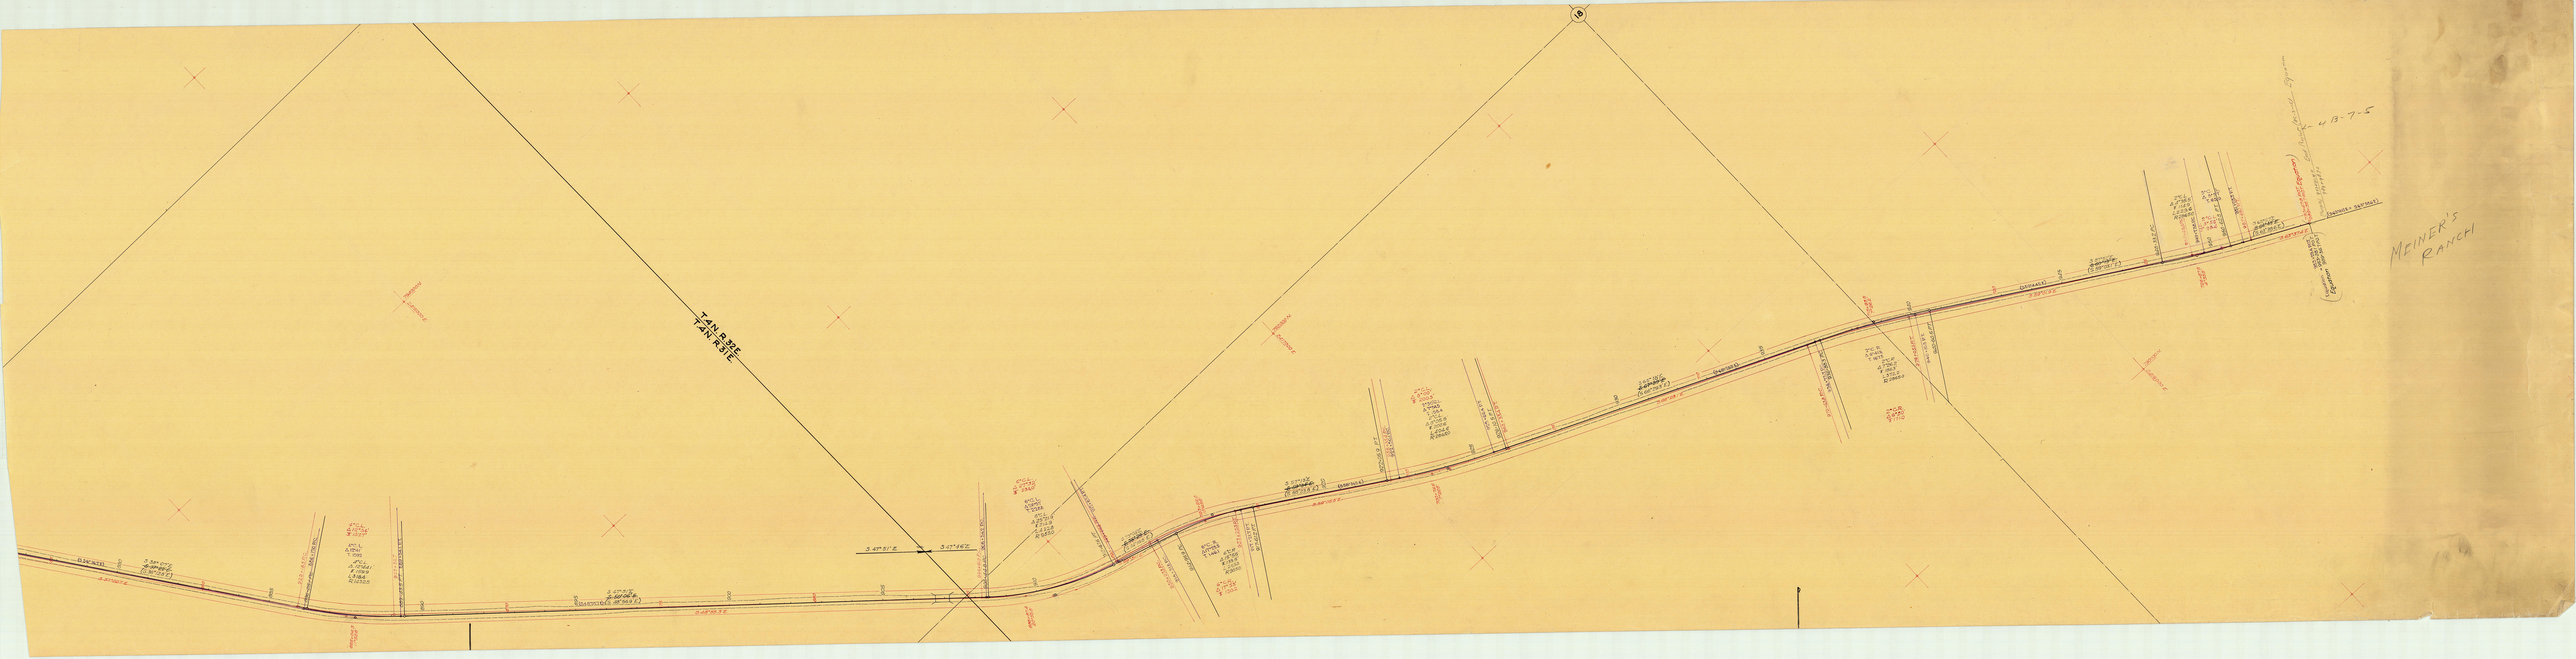
S 49° 51' E
S 47° 56' E
MEINER'S RANCH