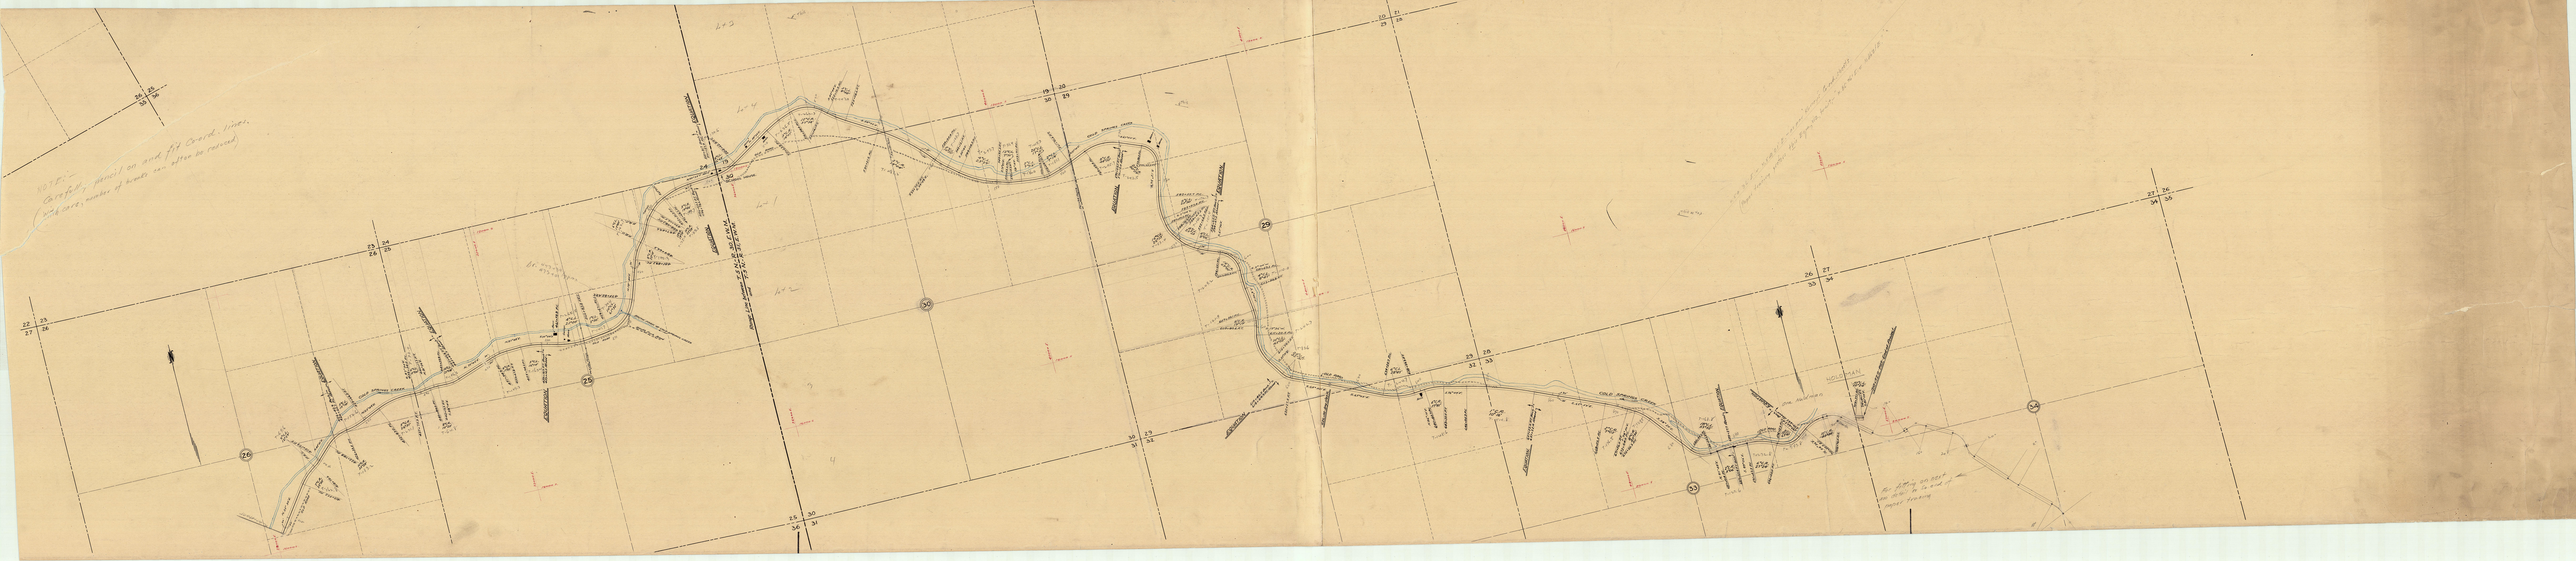
NOTE:
Carefully plotted on and off Creek lines.
Approx. number of bends can often be reduced.
Cow Creek
Cow Creek
Cow Creek