OREGON STATE HIGHWAY COMMISSION

UMATILLA COUNTY

VINSON - PILOT ROCK SECTION

OREGON WASHINGTON HIGHWAY

MAP

CONSTRUCTED LINE

Construction Commenced Aug 10th 1921.
Construction Completed May 8th 1922.
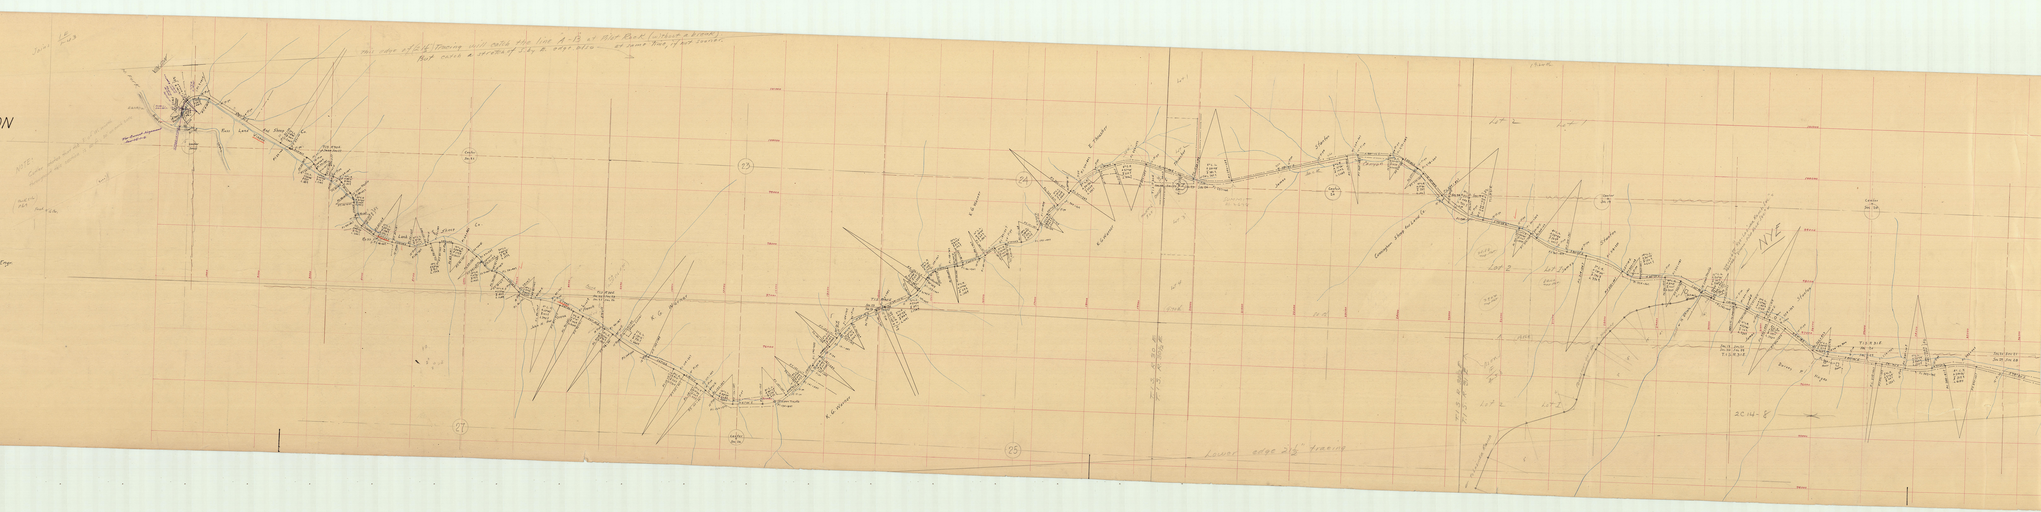
Scale 1" = 400 ft
Oscar Collier Res. Engr.
R.H. Baldock Div. Engr.
Herbert Nunn State Highway Engr.