OREGON STATE HIGHWAY DEPARTMENT.
SEAMAN AND KAMELA SECTION.
OLD OREGON TRAIL - UMATILLA COUNTY.

MAP OF CONSTRUCTED LINE

SCALE: 1 IN = 400 FT. SEPT. 15, 1923.

Note: Plan and Profile Equal. Refer to Sheet No. 7 of 1917 Ref. Road Map.


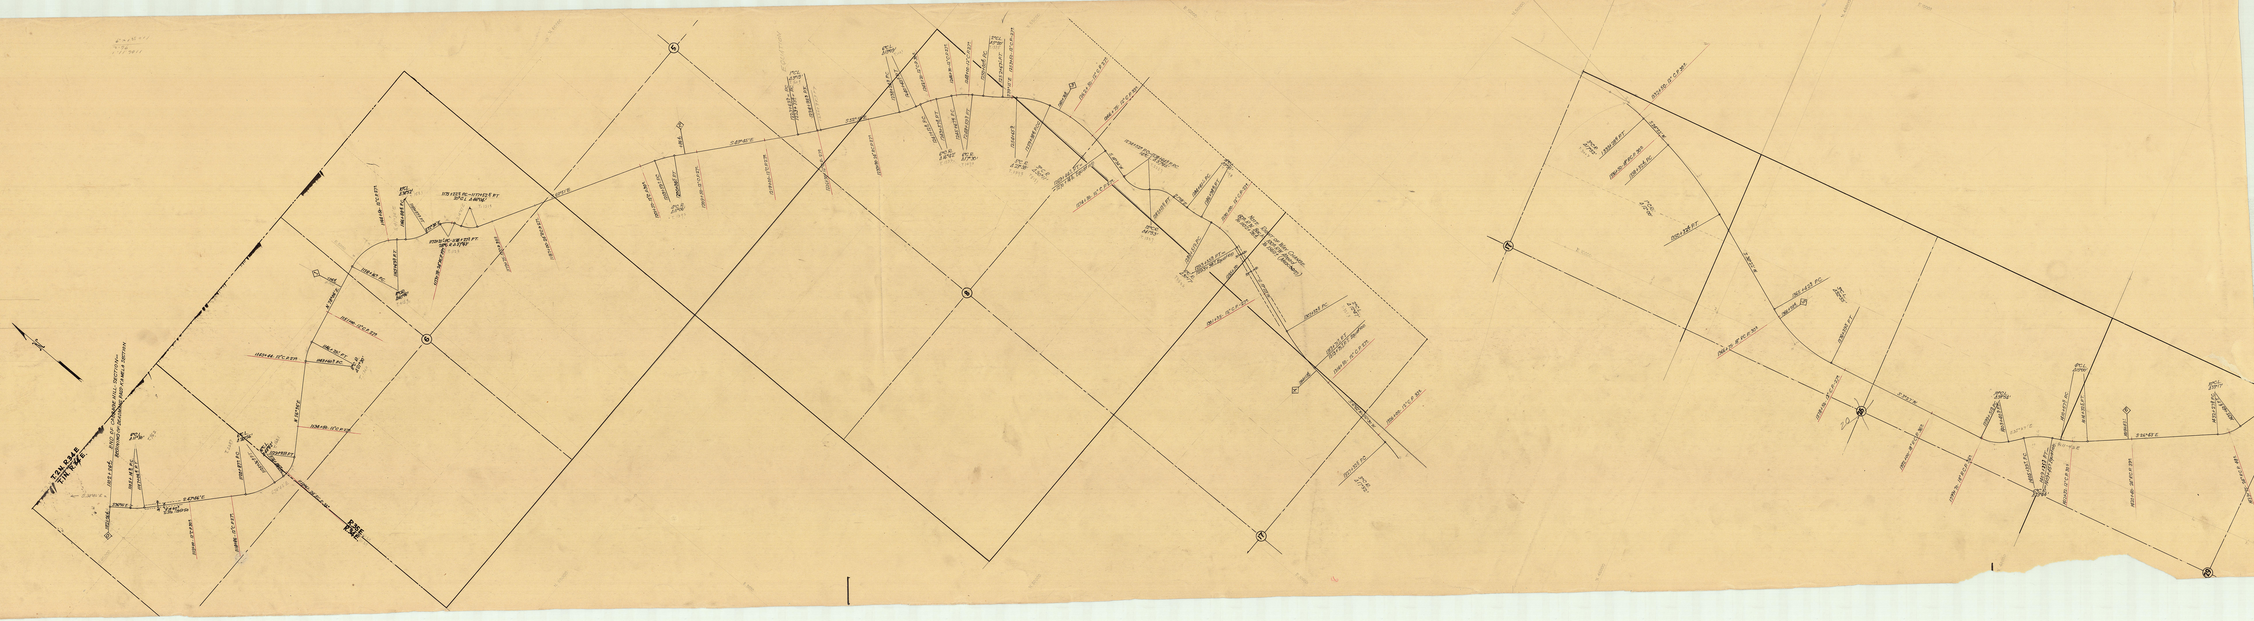
T.2N. R.2E.
T.1N. R.2E.
W.M.
SEAMAN
KAMELA
BEGINNING OF CONSTRUCTED LINE
END OF CONSTRUCTED LINE
