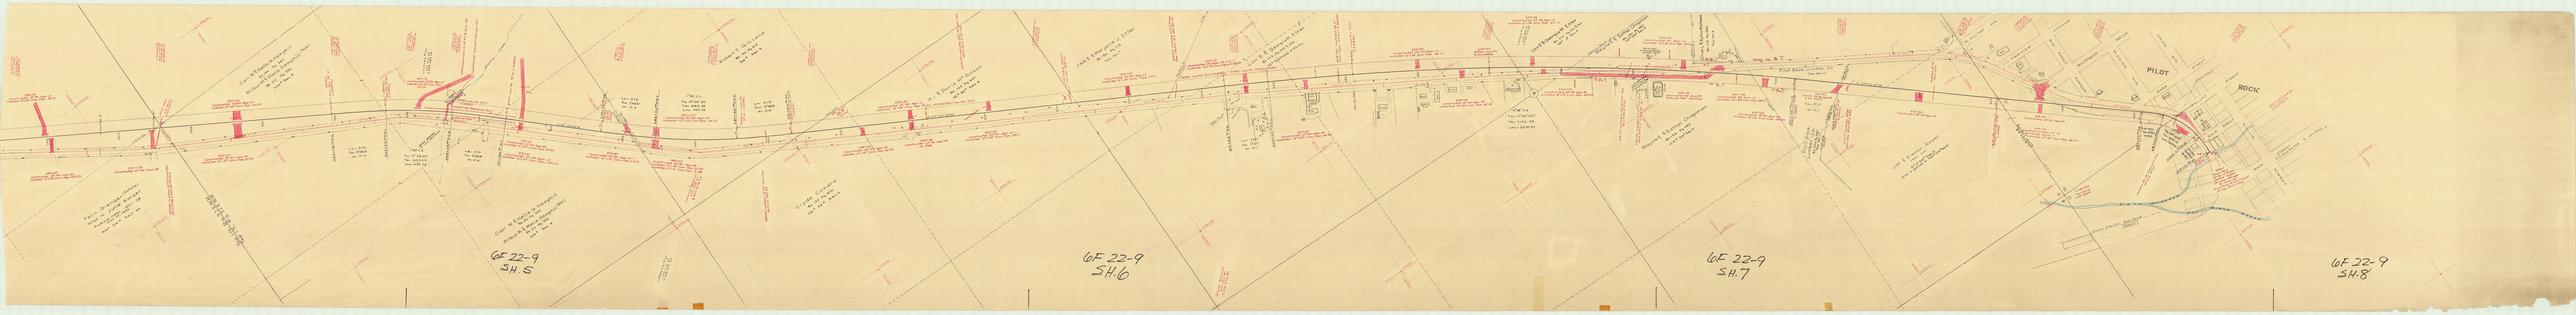
6F 22-9
SH.5
6F 22-9
SH.6
6F 22-9
SH.7
6F 22-9
SH.8
PILOT
ROCK