
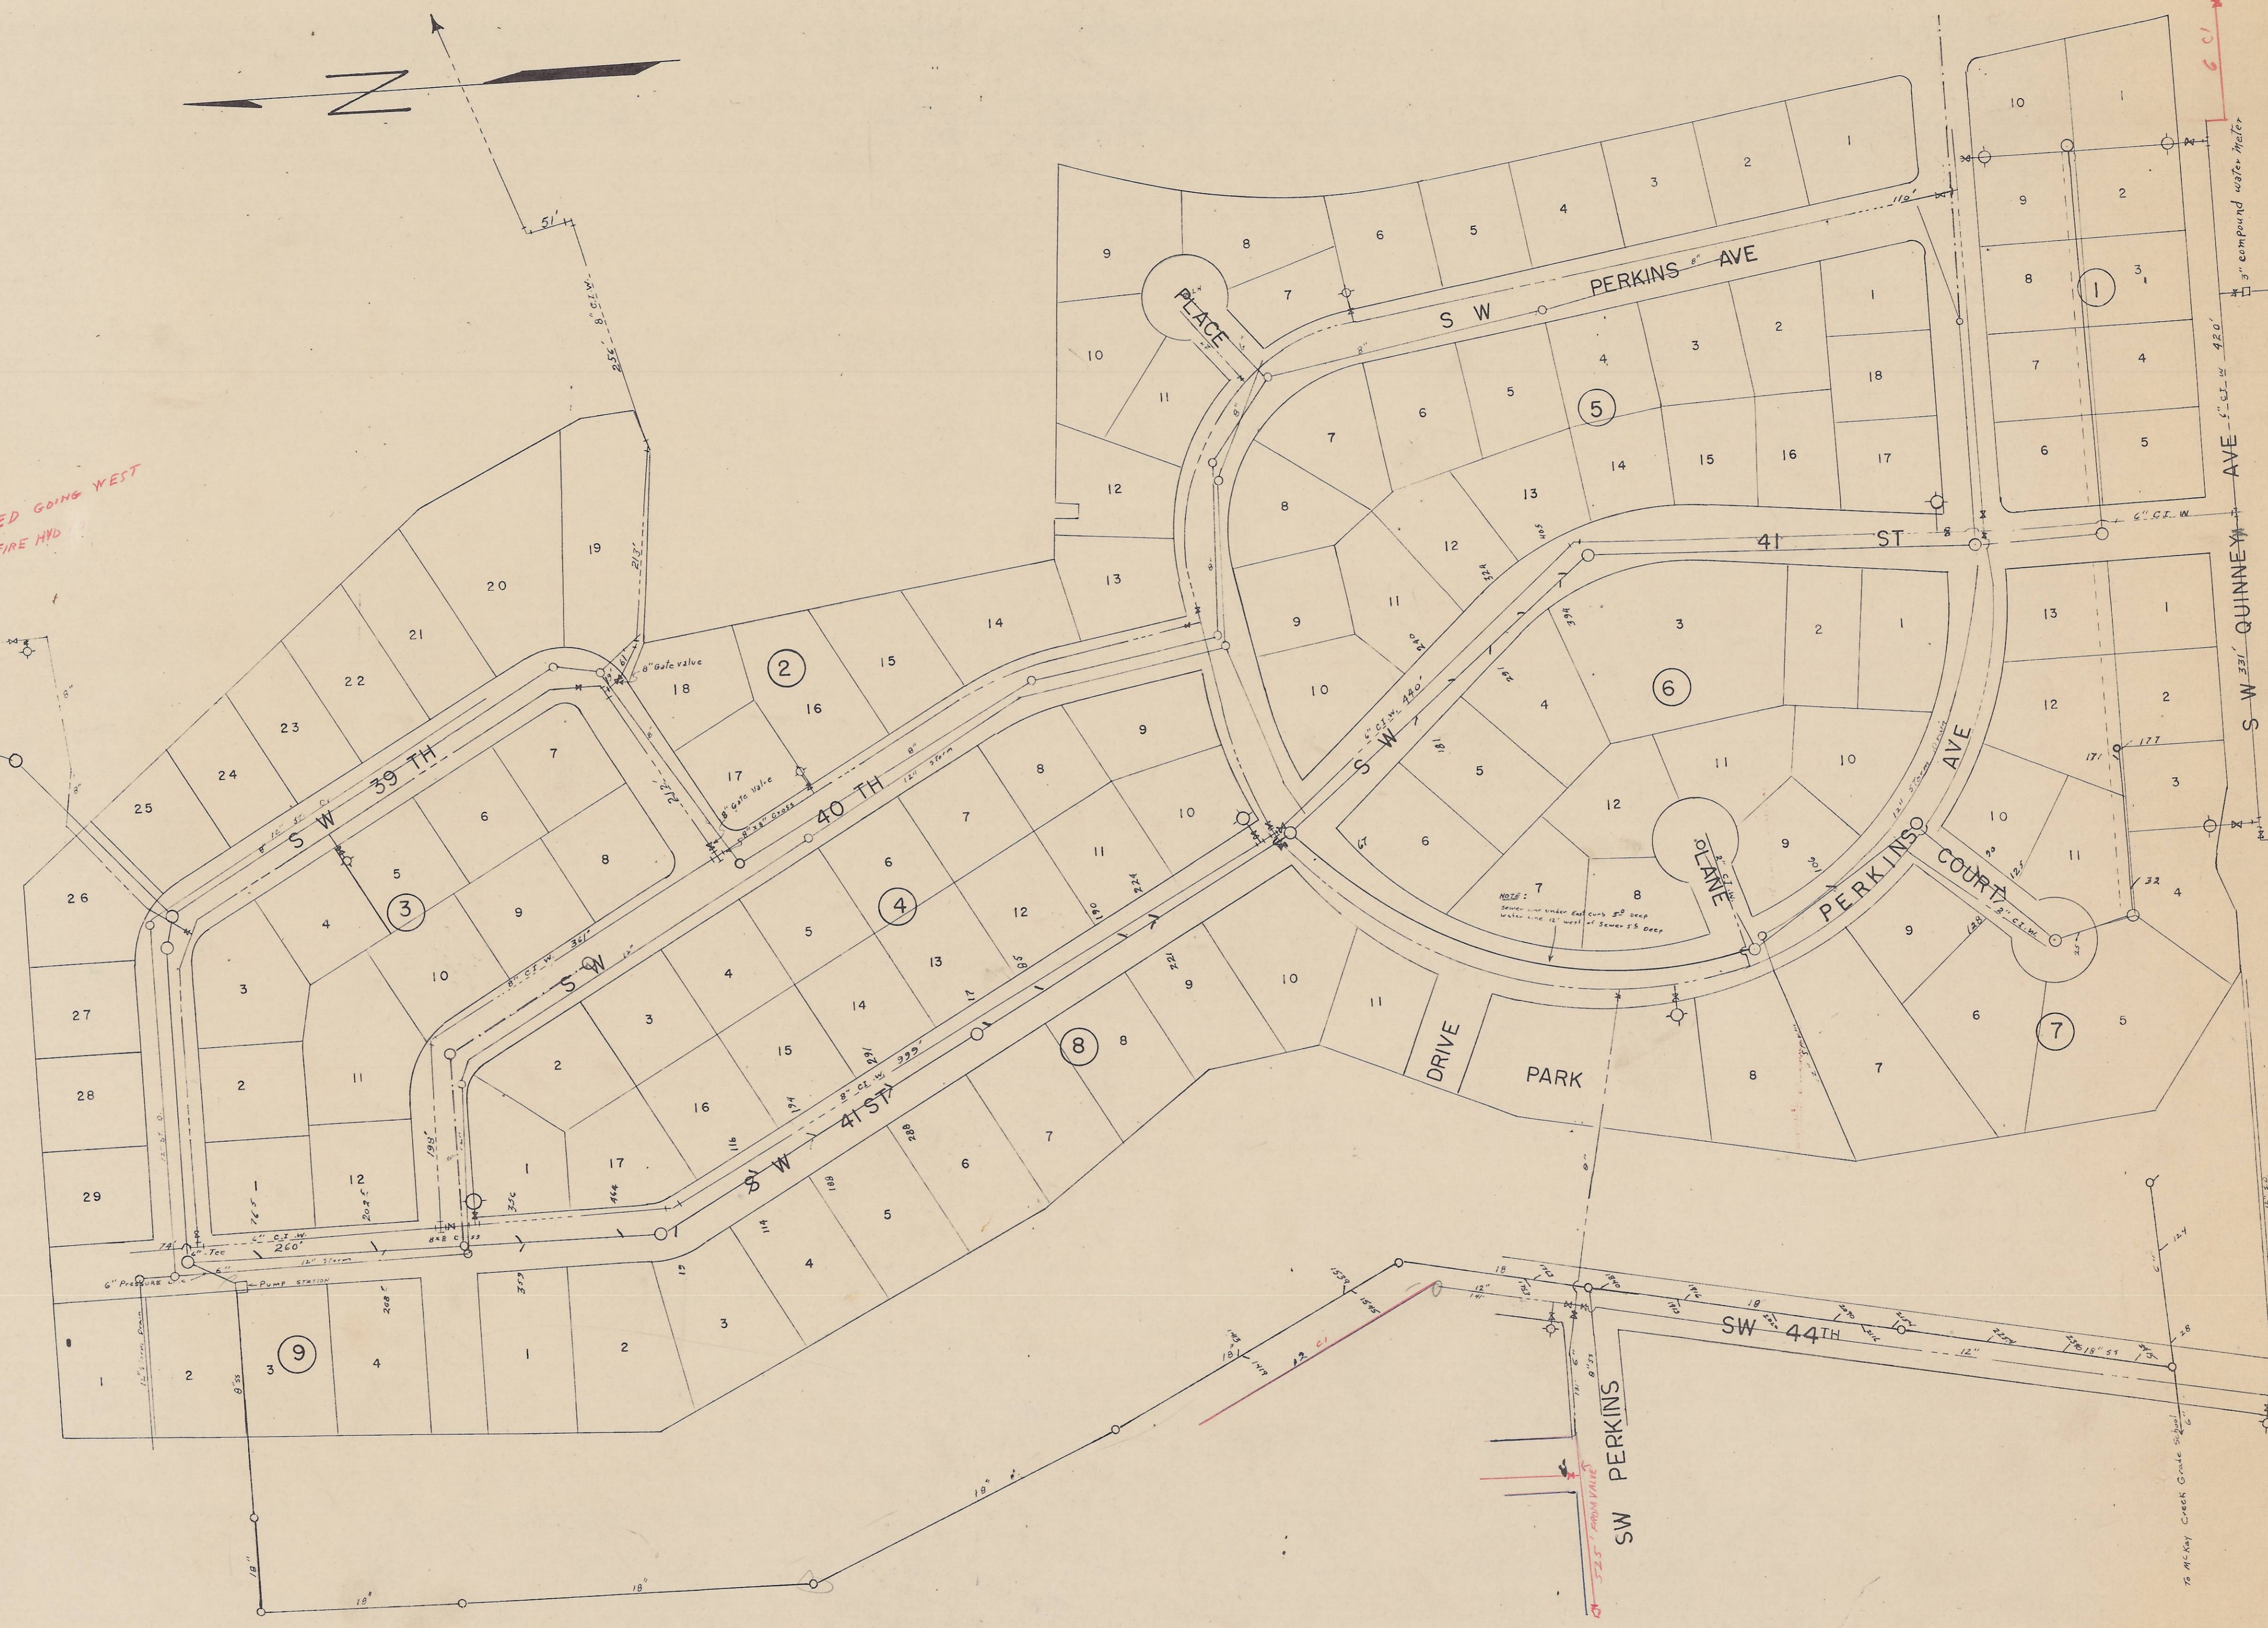


8x6 TEE PLUGED GOING WEST  
162' NORTH OF FIRE HYD  
OUT

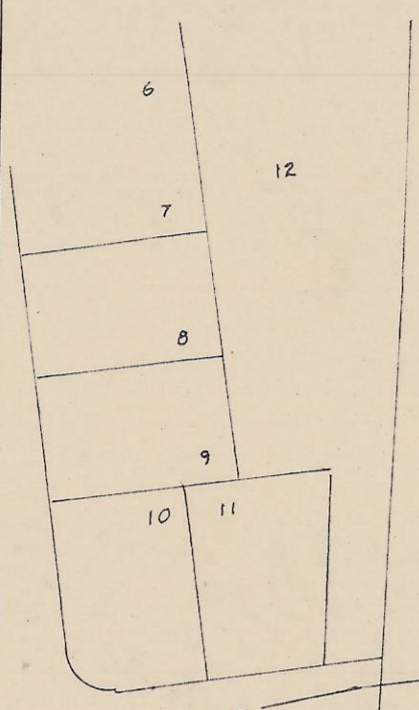

To McKay creek water dis