



BOX "DD"
MILTON TAP LINE
BDA

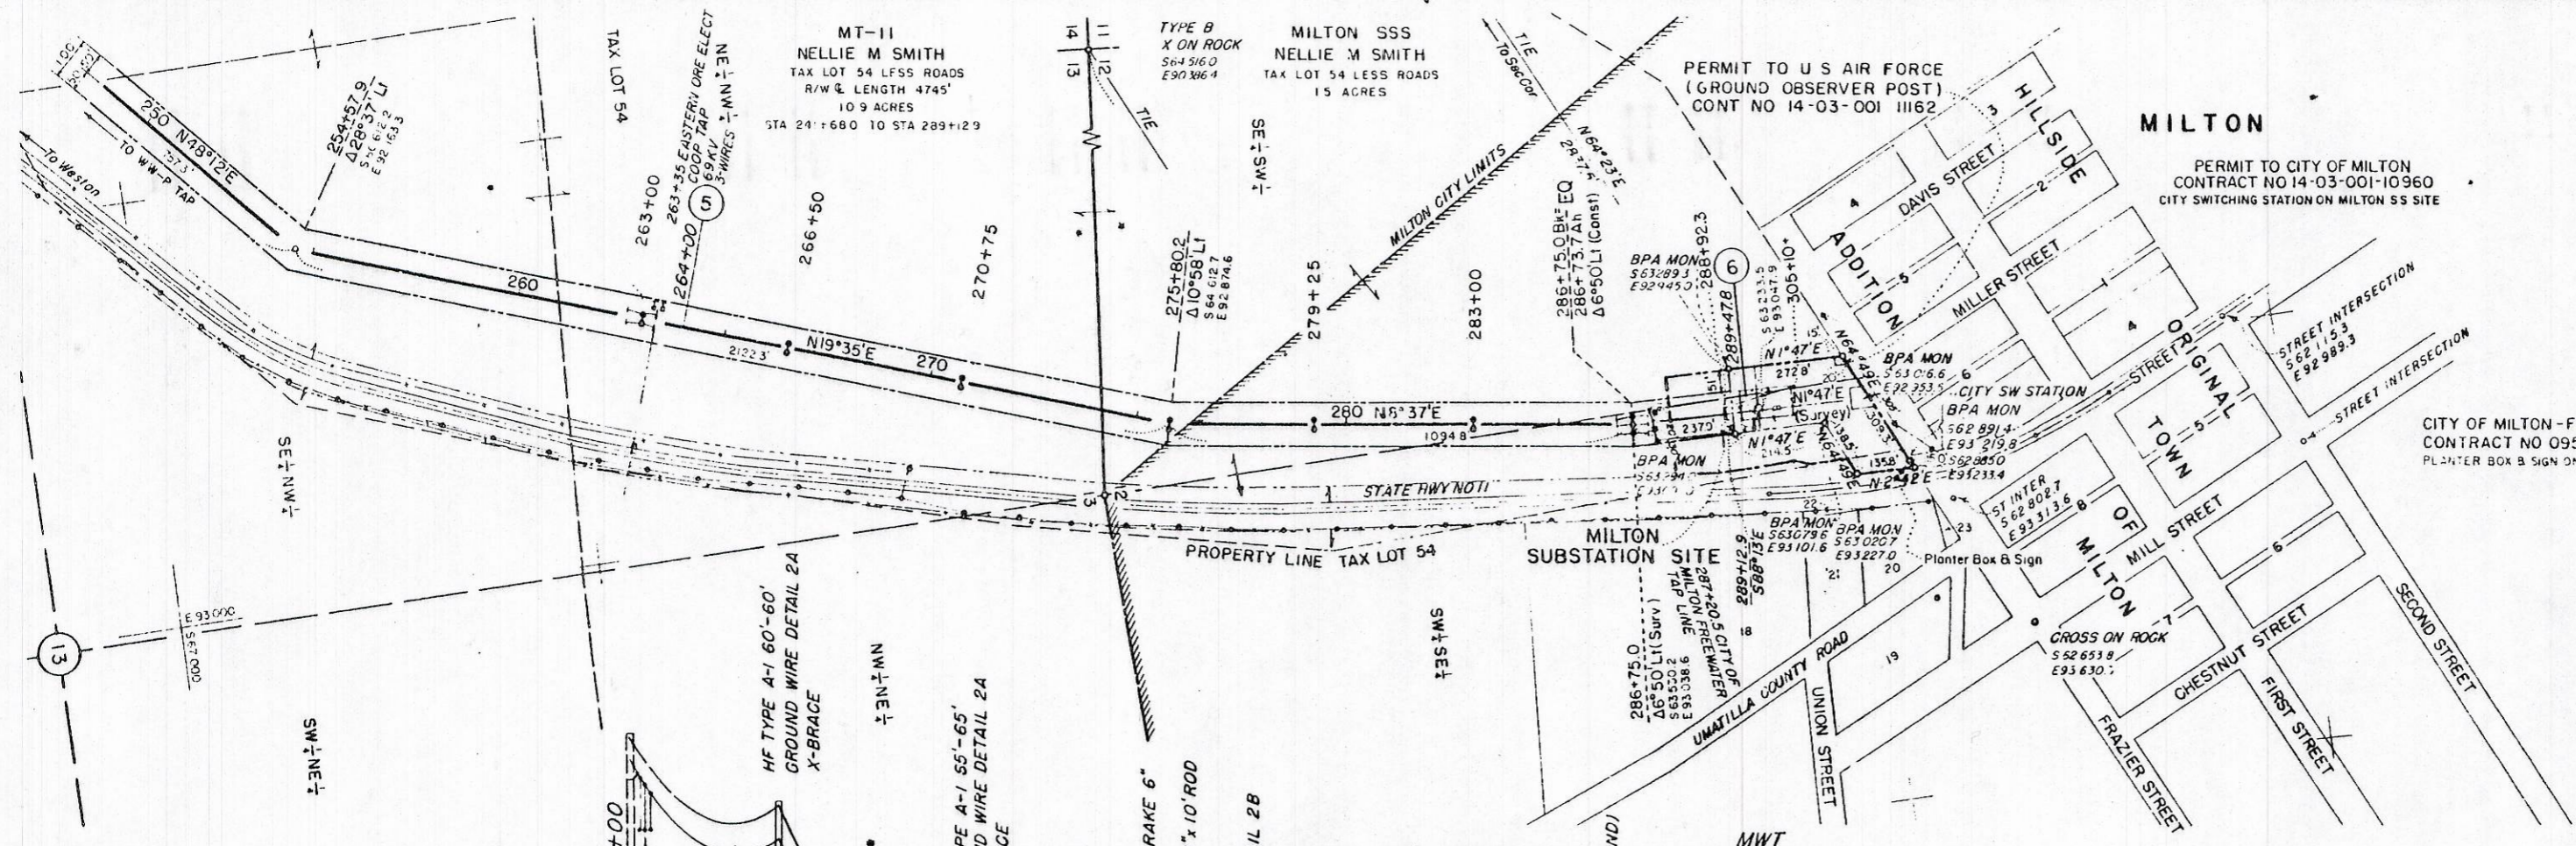

HORIZONTAL SCALE 1" = 200'
VERTICAL SCALE 1" = 20'

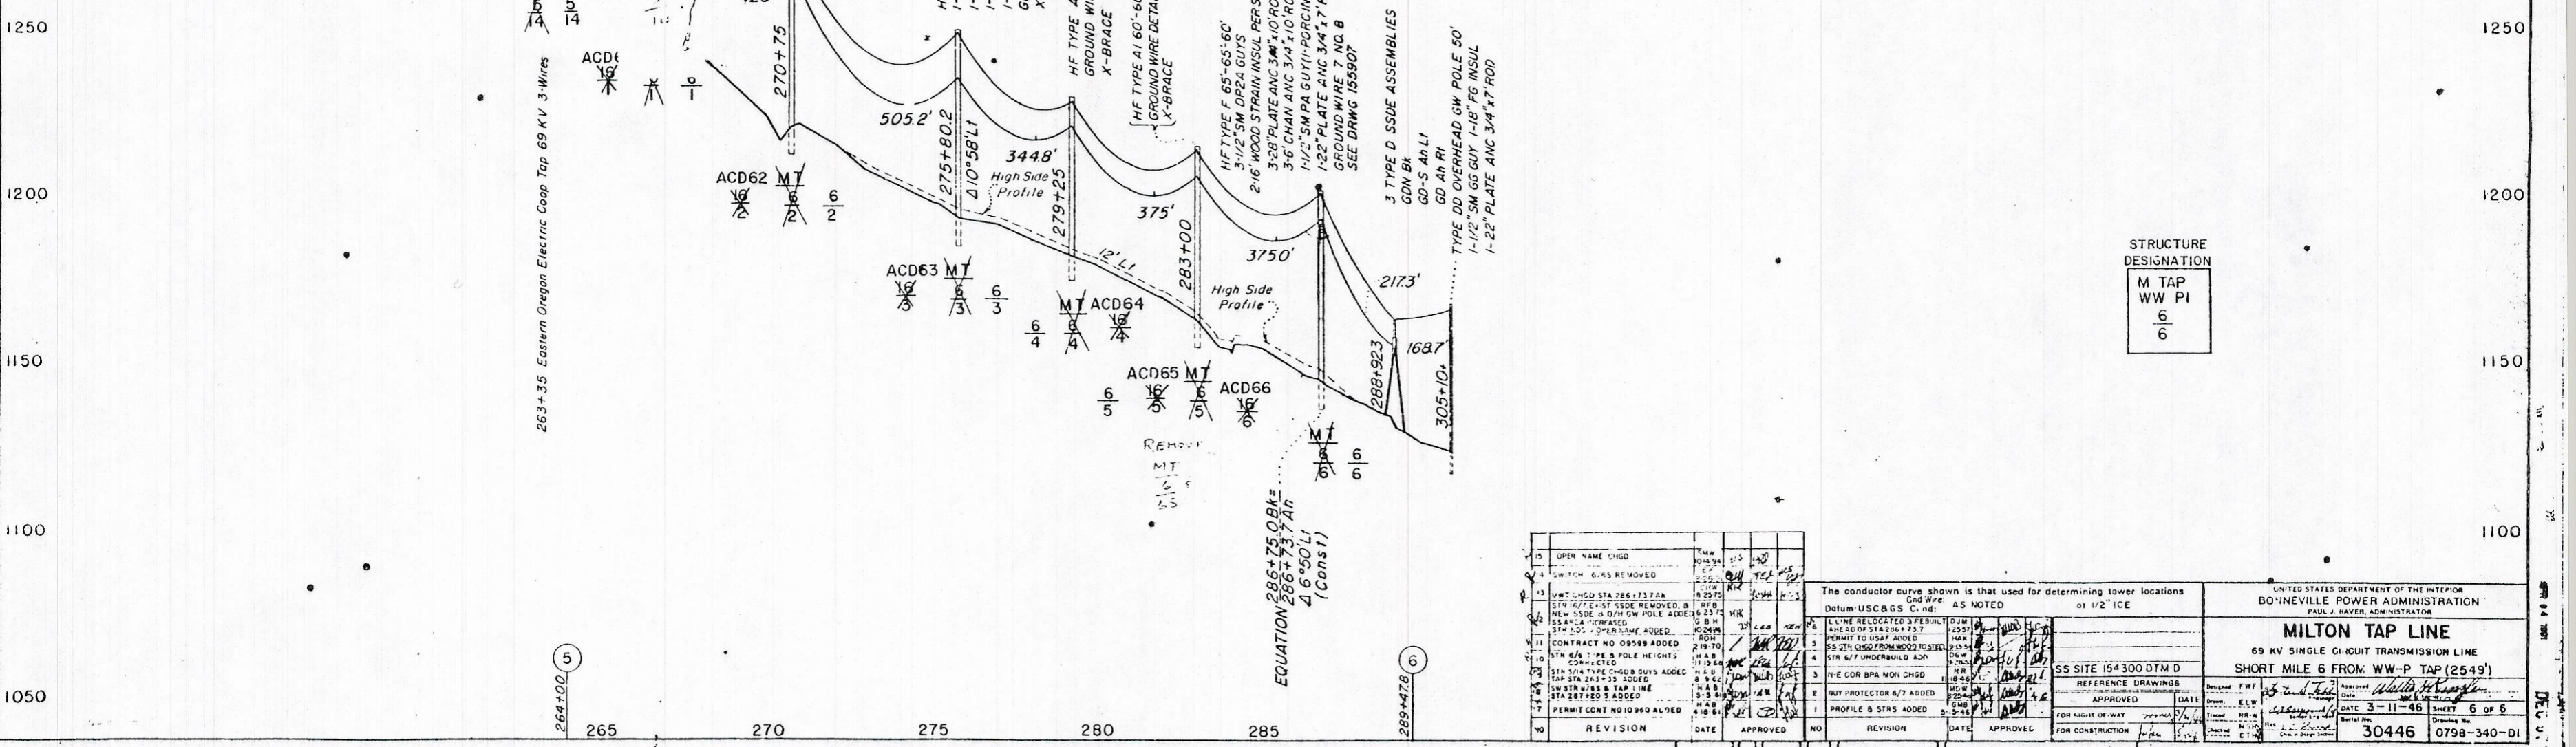

STRUCTURE DESIGNATION
M TAP
WW PI
6
6

NO	REVISION	DATE	APPROVED	NO	REVISION	DATE	APPROVED
